

Jolted well Service

State Well Report

Part I - Driller's Log

Mississippi Department of Environmental Quality
Office of Land and Water Resources

P.O. Box 2309
Jackson, MS 39225
(601)961-5210
(601)961-5228 (fax)

For Office Use Only:

Aquifer: B 79
Well #: _____
L. S. Elevation: _____
E-log #: _____

County: Coahoma
Permit #: GW-46886
Driller: Joel Jumper
Date drilling completed: 2-3-13

State Law requires that this report be prepared by the license holder responsible for the work and filed with the Department at the above address within 30 days of completion of drilling of the well or borehole.

Information on Well Owner <i>(Landowner if borehole is not for a water well)</i>	Well or Borehole Location
Owner Name: <u>Charlie Craig</u>	Latitude: <u>34° 22' 18"</u> Longitude: <u>90° 37' 10"</u>
Mailing Address: <u>Po Box 129</u>	Method of Lat/Long (circle one): Conventional Survey, USGS quad, <u>Hand-held GPS</u> , Survey-grade GPS
<u>Miss Point Ms 38631</u>	<u>500</u> 1/4 <u>SW</u> 1/4 Sec <u>2V</u> Twn <u>29N</u> Rng <u>04W</u>
City State Zip Code	Distance <u>1</u> Miles Direction <u>E</u> of Nearest Town <u>Miss Point</u>
Telephone No. () _____	

Well / Borehole Data

Date drilling started: 2-3-13 Date drilling completed: 2-3-13 Hole depth: 115 Hole diameter: 28 in

Location of the source of any surface water used for drilling: Nearest Well

Method of dosing and volume of Chlorine used in drilling and development: _____

Logs run (circle all applicable): No log run Electric Gamma Ray Density Sonic Neutron Other: _____

Name of organization running log(s): _____

Purpose of borehole (check one): Water Well Geotechnical/Geological Investigation Ground Source Heat Pump
Seismic Survey Other (describe) _____

If drilling is not related to water well construction, skip the remainder of this block

Purpose of Well (check one): Home Industrial Public Supply Irrigation Fish Culture Other: _____

If a flowing well, method of flow regulation: Valve _____ Other (describe) _____

Static Water Level: 20 feet above or below (circle one) land surface Date measured: 2-3-13

Method of Measurement (circle one) steel tape electric tape air line other: _____

Well depth: 115 Well grouted to a depth of _____ feet Type of grout (circle one): Neat Cement Bentonite Mix

Casing length: 75 feet Casing diameter: 16 inches Type of casing: PVC

Screen length: 40 feet Screen diameter: 16 inches Type of screen: PVC

Screen slot size: .50 inches Setting depth: From 0 feet to 70 feet

Type of completion (circle all applicable) Gravel packed Underreamed Telescoped Open hole Natural Development
Other (describe): _____

Top of lap pipe or reduction in casing: _____ feet. *If telescoped or more than one screen, describe on next page*

Form: OLWR-SWR-1A (04/08)



RECEIVED

FEB 13 2013

BY: OLWR

902-0177

B79
13 21 2809 420328
440336

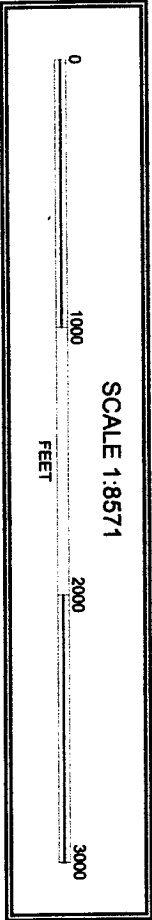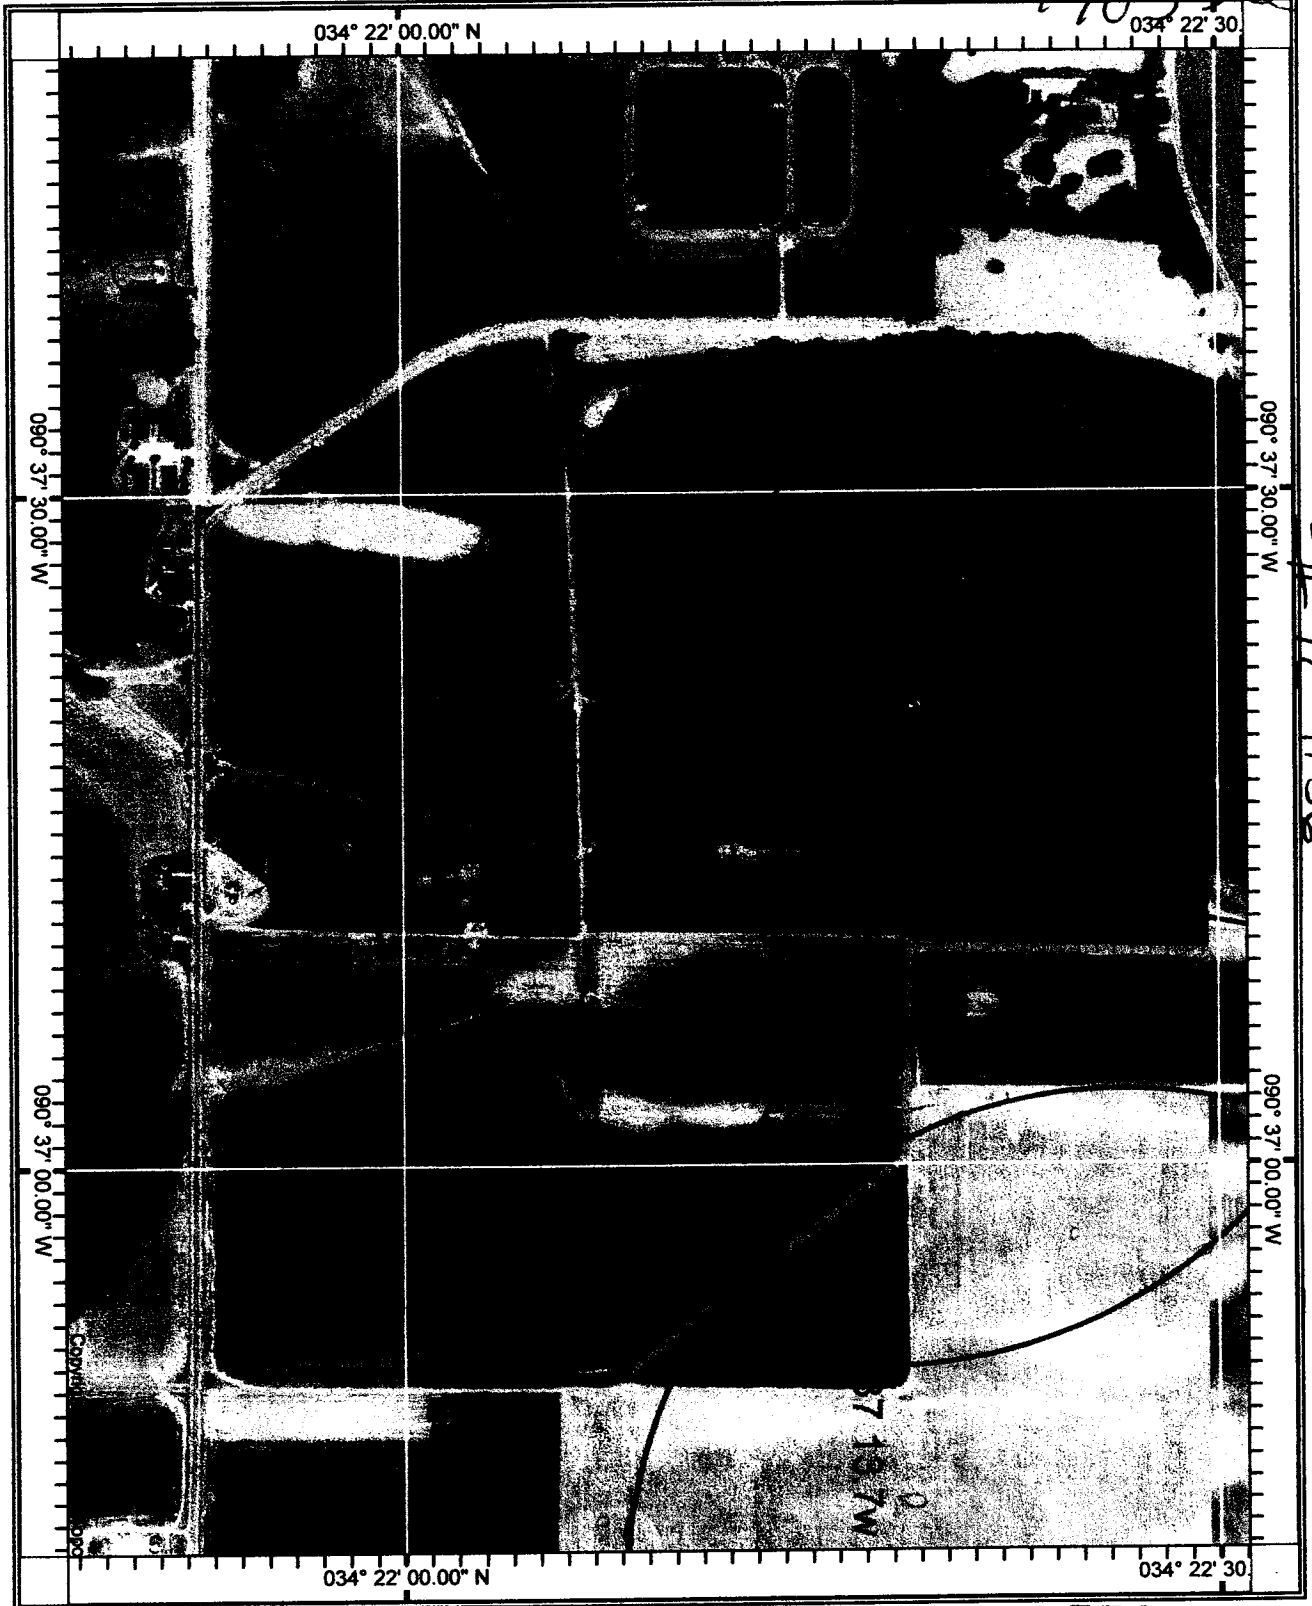

17-1136

RECEIVED
FEB 13 2013
BY: OLWR