County:	Coahoma
ſ	GW-47053 /
	Irrigation Equipment
Date drill	ing completed: 04/15/2013

State Well Report

Part 1 - Driller's Log

Mississippi Department of Environmental Quality
Office of Land and Water Resources
P.O. Box 2309
Jackson MS 39225

Jackson, MS 39225 (601) 961-5210 (601) 961-5228 (fax)

F	or Office Use Only:
Aquiter:	
Well #:	B80
L.S. Elevation:	
E-log #	

State Law requires that this report be prepared by the license holder responsible for the work and filed with the Department at the above address within 30 days of completion of drilling of the well or borehole.

Department at the above	auaress wunin 30 aays	of completion of ariting of the weit of borenote.
Information on Well ((Landowner if borehole is not fo		Well or Borehole Location
Owner Name Tim Morris		Latitude: 34 ° 21 ' 26" " Longitude: 90 ° 38 ' 20 "
Mailing Address: 6135 Friars Point Roa		Method of Lat/Long (check one): Conventional Survey,
		☐ USGS quad, ☐ Hand-held GPS, ☐ Survey-grade GPS
Clarksdale	Ms 38614	NW ¼ SW ¼ Sec 29 √ Twn 29 N Rng 4 W
City	State Zip code	Distance Direction Nearest Town
Telephone No(Miles ofFriars Point
	Well / B	orehole Data
Date drilling started: 04/15/2013 Date	te drilling completed: 04/	/15/2013 Hole depth: 122 Hole diameter: 18"
Location of the source of any surface water us Method of dosing and volume of Chlorine use		
Logs run (check all applicable): No log running log(s):	un 🗌 Electric 🔲 Gamm	na Ray Density Sonic Neutron Other:
Purpose of borehole (check one): Water	r Well Geotechnica	al/Geological Investigation Ground Source Heat Pump
☐ Seism	nic Survey	(describe)
If drilling is not	t related to water well c	onstruction, skip the remainder of this block
Purpose of Well (check one) Home	☐ Industrial ☐ Public St	upply ☑ Irrigation ☐ Fish Culture ☐ Other:
If flowing, method of flow regulation: Valve	Other (d	escribe)
Static Water Level: 22 feet above of	or below (check one)	and ⊠ surface Date measured: 04/15/2013
Method of Measurement (check one) ⊠ ste	eel tape	air line other:
Well depth: 122 Well grouted to a d	depth of feet	Type of grout (check one): ☐ Neat Cement ☑ Bentonite ☐ Mix
Casing length: 82 feet Cas	sing diameter: 10	inches Type of casing: PVC
Screen length: 40 feet Scr	reen diameter: 10	inches Type of screen: PVC
Screen slot size:050 inche	es Setting depth: From	88 82 feet to 122 feet
Type of completion (check all applicable):	☐ Gravel packed ☐	Underreamed
	Other (describe):	
Top of lap pipe or reduction in casing:	feet.	If telescoped or more than one screen, describe on next page

RECEIVED

'APR 1 8 2013

BY: OLWR

The statch	helaw	anly	required	for water wells	
I WE SWEICH	UEWN	only	I CHMH EA	JUI WHILL WELLS	

ı	famili es	lescopes.	ch au	danthe	~= -	- dech
ı	well te	riescopes.	SHOW	aevous	on s	Ketcn.

Į	f well t	elescopes,	show	depths	on si	ketch.

Ground level

Desci	iption	n of forma	uions e	ncountered	must b	e prov	ided for all
							regulations

Description of Formations Encountered	From (depth)	To (depth)
Clay	Ground level	19
Fine Sand	20	38
Fine Sand & Gravel	39	46
Medium Sand & Gravel	47	122
		<u> </u>
		<u> </u>
		ļ
		
		-
		
		<u> </u>

If more than one screen, show location of each on sketch

Sketch the property la	yout and include the follow	ving: 1) the well location; 2)	any permanent structures on tems that may aid in locating the	he property that may
	orth arrow.	aus, power mies, or omer ne	ins that hay and in rooming the	property and no west,
Landowner Name:	Tim Morris			
			<u> </u>	Form: OLWR-SWR-1A (04/08)
I certify that the well/bo	orehole was drilled, construc	ted, and completed in accorda	ance with all applicable requires at of Health regulations, if appli	nents of the cable, and state
laws.			V.	
Print Name of Responsible Lice	0695	04/17/2013 Date	Signature of Licensee	RECEIVED
1 140 : 1400 of Responsible De	A STEER AND STEER STEER STEER			
				APR 1 8 2013
	4 Dist. 044 040 0400 Forms			

BY: OLWR

STATE WELL REPORT

Part 2 **Pump Installer's Completion Report**


Mississippi Department of Environmental Quality Office of Land and Water Resources P.O. Box 2309 Jackson, MS 39225 (601) 961-5210 (601) 961-5228 (fax)

For Office Use Only:			
Aquifer:		_	
Well #:	<u>B80</u>	_	
Elevation			

Permit #: GW-47053 Driller: Irrigation Equipment Date drilling completed: 04/15/2013 Copy information from block on Part 1

County: Coahoma

Well Owner Info	ormation	Well Location Latitude: 34 21' 20.7 N Longitude: 90 38' 20.1 W Method of Lat/Long (check one): ☐ Conventional Survey, ☐ USGS quad, ☐ Hand-held GPS, ☐ Survey-grade GPS		
Owner Name: Tim Morris	·			
Mailing Address: 6135 Friars Point	Road			
Clarksdale City Telephone No. () -	State Zip code	NW ½ SW ½ Sec 29 T 29 N R 4 W Distance Direction Nearest Town Miles South of Frair Point		
Pump Typ Check on		Power Type Check one		
☐ Air Lift ☐ Jet	Submersible	☐ Diesel Engine ☐ Gasoline Engine ☐ Natural Gas		
☐ Bucket ☐ Piston	☐ Turbine	☐ Electric Motor ☐ Hand ☐ Tractor PTO		
☐ Centrifugal ☐ Rotary	Flowing Well	☐ Windmill ☐ Other (specify):		
Other (specify):		Horse Power Rating of Motor: 25		
Date Pump Installed: 04/15/2013		Setting Depth: 70 feet		
Rated Pump Capacity 900+/-	Gallons Per Minute	Number of Stages: 1		
Pump Test	Data	Method of Measuring Water Level Check one		
Date Well Tested:		Air Line		
Static Water Level (A): Pumping Water Level (B):		Other (specify):		
Drawdown [(B) - (A)]:	Feet Below Land Surface	For flowing well, measured shut in head: feet		
Test Pumping Rate:		Well yielded GPM with a drawdown of		
Duration of Pump Test (minimum 4 hou		feet after hours of pumping		
		ment of Existing Pump Repair of Existing Pump RECEIVE		
I HEREBY CERTIFY that the above sta	atements are true to the best of m			
Print Name of Pump Installer and Lice	0695 ense No. (if applicable)	APR 1 8 2013		

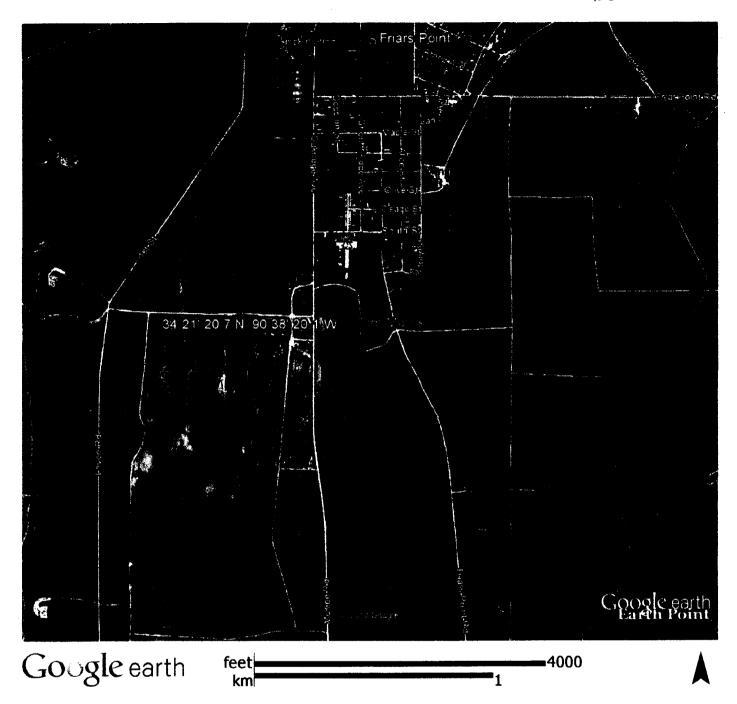

RECEIVED

APR 1 8 2013

BY: OLWR