

STATE WELL REPORT

Part 1

Driller's Log

Mississippi Department of Environmental Quality
Office of Land and Water Resources
P.O. Box 2309
Jackson, MS 39225-2309
(601)961-5210
(601)360-0535 (fax)

For Office Use Only:

Well #: B81
Aquifer: _____
E-Log #: _____

County: Cochema
Permit #: CW-47207
Driller: Tommy Peacock
Date drilling completed: 5/31/13

State Law requires that this report be prepared by the license holder responsible for the work and filed with the Department at the above address within 30 days of completion of drilling of the well or borehole.

Well Owner Information (Landowner if borehole is not for a water well)	Well or Borehole Location
Owner Name: <u>Mc Kee Brothers Trust</u>	Latitude: <u>34-26-51</u> Longitude: <u>90-34-48</u>
Mailing Address: <u>PO Box 171133</u>	Method of Lat/Long (check one): Conventional Survey _____, USGS quad _____, Hand-held GPS <input checked="" type="checkbox"/> , Survey-grade GPS _____
<u>Memphis</u> <u>TN</u> <u>38157</u>	<u>NE 1/4 NW 1/4, Sec 35 T 29N R 04W</u>
City State Zip Code	Miles _____ of _____ (Distance) (Direction) (Nearest Town)
Telephone No. (____) _____	

Well / Borehole Data
Date drilling started: <u>5/31/13</u> Date drilling completed: <u>5/31/13</u> Hole depth: <u>115</u> Hole diameter: <u>20"</u>
Location of the source of any surface water used for drilling: <u>ditch 2 miles from well location</u>
Method of dosing and volume of Chlorine used in drilling and development: <u>Chlorinated in tank</u>
Logs run (circle all applicable): <input checked="" type="checkbox"/> No log run <input type="checkbox"/> Electric <input type="checkbox"/> Gamma Ray <input type="checkbox"/> Density <input type="checkbox"/> Sonic <input type="checkbox"/> Neutron <input type="checkbox"/> Other: _____
Name of organization running log(s): _____
Purpose of borehole (circle one): <input checked="" type="checkbox"/> Water Well <input type="checkbox"/> Geotechnical/Geological Investigation <input type="checkbox"/> Ground Source Heat Pump <input type="checkbox"/> Seismic Survey <input type="checkbox"/> Other (describe) _____
<i>If drilling is not related to water well construction, skip the remainder of this block</i>

Purpose of Well (circle all applicable): Home Industrial Public Supply <input checked="" type="checkbox"/> Irrigation <input type="checkbox"/> Fish Culture
Other (describe): _____
If a flowing well, method of flow regulation: Valve _____ Other (describe) _____
Static Water Level: _____ feet [above or below] land surface Date measured: _____ (circle one)
Method of measurement (circle one): Steel tape Electric tape Air line Other (describe): _____
Well depth: <u>115</u> Well grouted to a depth of: <u>10</u> feet Type of grout (circle one): Neat Cement <input checked="" type="checkbox"/> Bentonite Mix
Casing length: <u>75</u> feet Casing diameter: <u>10"</u> inches Type of casing: <u>PVC</u>
Screen length: <u>40</u> feet Screen diameter: <u>10"</u> inches Type of screen: <u>PVC</u>
Screen slot size: <u>.50</u> inches Setting depth: From <u>75</u> feet to <u>115</u> feet
Type of completion (circle all applicable): <input checked="" type="checkbox"/> Gravel packed <input type="checkbox"/> Underreamed <input type="checkbox"/> Open hole <input type="checkbox"/> Natural development
Other (describe): _____
Top of lap pipe or reduction in casing: _____ feet

If telescoped or more than one screen, describe on next page

RECEIVED
JUL 01 2013
BY: OLWR

County: Cochran
 Permit #: BW-47207

For Office Use Only:
 Well #: B81

The sketch below only required for water wells

If well telescopes, show depths on sketch.

Ground Level →

0	15'	Clay
15	10'	sand & clay
25	10'	med. clay
35	30'	med sand
65	40'	coarse sand & gravel
105	10'	coarse sand

If more than one screen, show location of each on sketch

Description of formations encountered must be provided for all wells and boreholes, unless specifically exempted by regulations

Description of Formations Encountered	From (depth)	To (depth)
Clay	Ground level	15
sand & clay	15	25
Clay	25	35
med. sand	35	45
" "	45	55
med sand	55	65
coarse sand & gravel	65	75
" "	75	85
" "	85	95
" "	95	105
coarse sand	105	115

Sketch the property layout and include the following:

- 1) the well location
- 2) any permanent structures on the property that may aid in locating the well
- 3) any roads, power lines, or other items that may aid in locating the property and the well
- 4) north arrow

RECEIVED

JUL 01 2013

BY: OLWR


Landowner Name: _____

I HEREBY CERTIFY that the well/borehole was drilled, constructed, and completed in accordance with all applicable requirements of the Mississippi Department of Environmental Quality and the Mississippi Department of Health regulations, if applicable, and state laws.

Tommy Peacock Sr #3909
 Print Name of Responsible Licensee and License No.

6-24-13
 Date

Tommy Peacock Sr
 Signature of Licensee

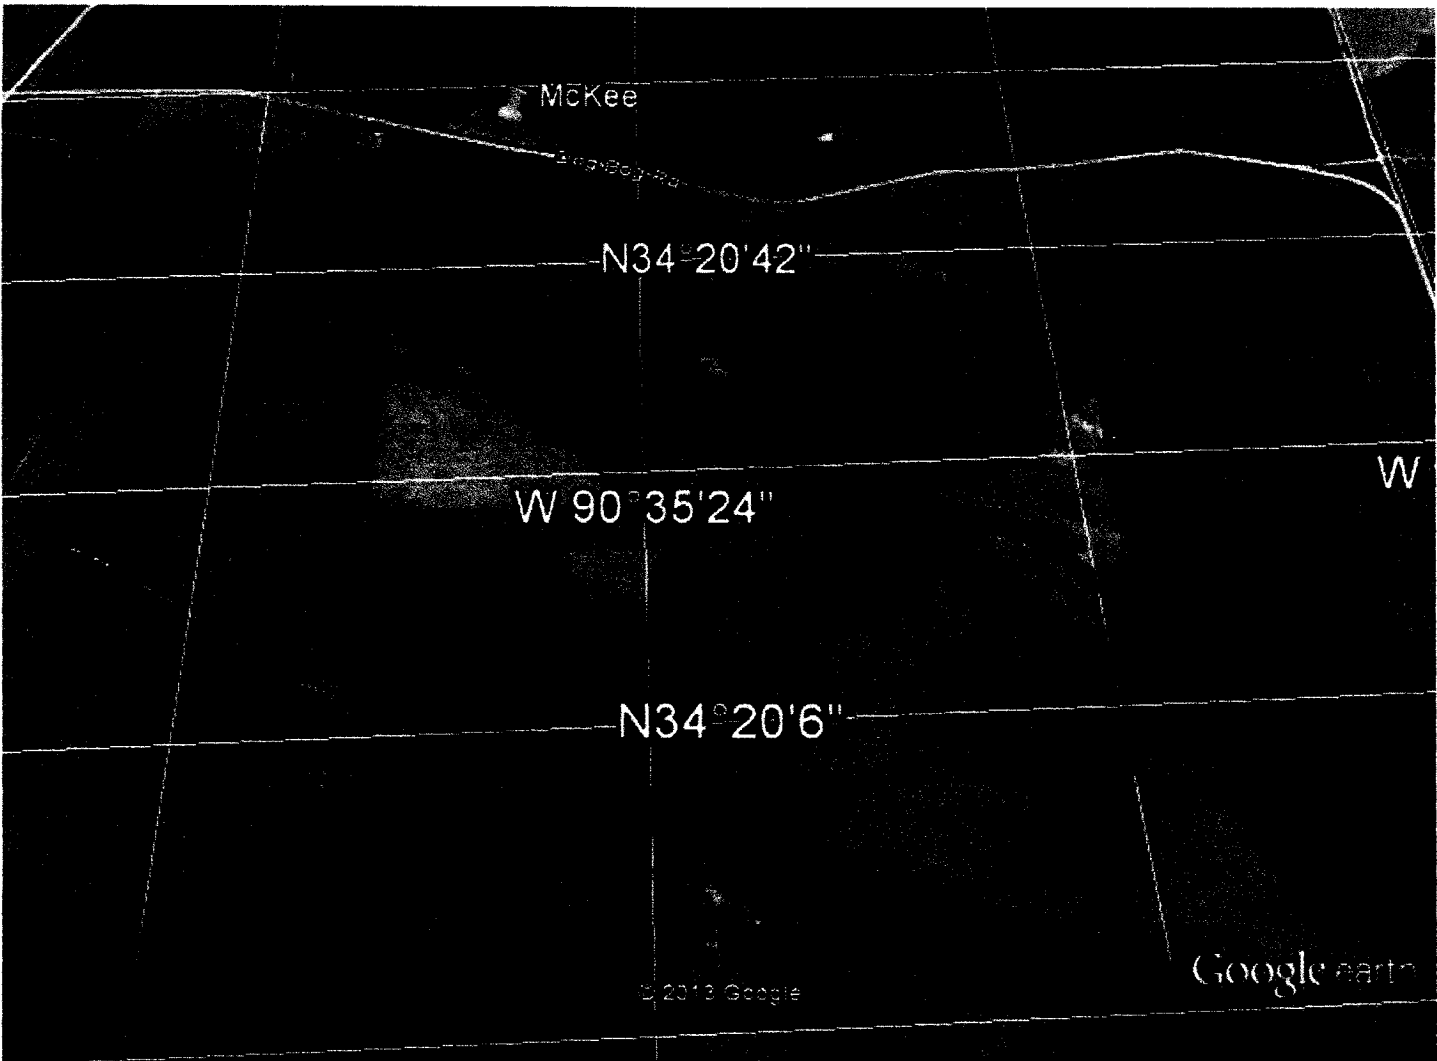

Google earth



RECEIVED

JUL 01 2013

BY: [Signature]

STATE WELL REPORT

Part 2

Pump Installer's Completion Report
 Mississippi Department of Environmental Quality
 Office of Land and Water Resources
 P.O. Box 2309
 Jackson, MS 39225-2309
 (601)961-5210
 (601) 360-0535 (fax)

For Office Use Only:

Well #: B81
 Aquifer: _____

County: COAHOMA
 Permit #: GW-47207
 Driller: TOMMIE PRACK
 Date completed: 5-31-13
Copy information from block on Part 1

This part of the report must be completed by a licensed water well contractor or a licensed pump installer. A copy of Part 1 of the report must be attached and both parts filed with the Department at the above address within 30 days of well completion.

Well Owner Information	Well Location
Owner Name: <u>McKEE BROTHERS TRUST</u>	Latitude: <u>34° 20' 51"</u> Longitude: <u>90° 34' 48"</u>
Mailing Address: <u>5872 RIDGEBEND RD</u>	Method of Lat/Long (check one): Conventional Survey _____, USGS quad _____, Hand-held GPS _____, Survey-grade GPS _____
<u>MEMPHIS</u> <u>TN</u> <u>38120</u>	<u>NE</u> ¼ <u>NW</u> ¼, Sec <u>35</u> T <u>29N</u> R <u>04W</u>
City State Zip Code	_____ Miles of _____ (Distance) (Direction) (Nearest Town)
Telephone No. <u>(901) 680-7700</u>	

Pump Type (circle one)

Submersible Turbine Air Lift Centrifugal Flowing Well Jet Piston Rotary Other (describe): _____

Date Pump Installed: 6-7-13 Rated Pump Capacity: 650 Gallons Per Minute

Is This Pump (circle one): New Repaired Replacement

Power Type (circle one)

Electric Diesel Gasoline Natural Gas Tractor PTO Windmill Other (describe): _____

Horse Power Rating of Motor: 15 Setting Depth: 60 feet Number of Stages: 1

Pump Test Data for Non Flowing Well

Date Well Tested: _____ Duration of Pump Test (minimum 4 hours): _____ hours

Static Water Level (A): _____ Feet Below Land Surface Pumping Water Level (B): _____ Feet Below Land Surface

Drawdown [(B) - (A)]: _____ Feet Below Land Surface Test Pumping Rate: _____ Gallons Per Minute

Method of measurement (circle one): Steel tape Electric tape Air line Other (describe): _____

Pump Test Data for Flowing Well

Measured shut in head: _____ feet.

Well yielded _____ GPM with a drawdown of _____ feet after _____ hours of pumping

Meter Installation

Meter Manufacturer: N/A Meter Serial Number: _____

Meter Model Number/Name: _____ Type of Meter: _____


Totalizer Register Unit and Multiplier Factor (AF x .001, gal x 1000, etc): _____

Installation Date: _____ Meter installed by: _____

Is This Meter (circle one): New Repaired Replacement

Important: By submitting the above information you are certifying that this meter was installed to manufacturer standards. For agricultural wells, a list of approved meters is on the MDEQ website.

I HEREBY CERTIFY that the above statements are true to the best of my knowledge.

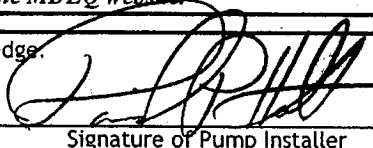DAVID P. HOLT 0-752P 6-23-13 

Print Name of Pump Installer and License No. (if applicable) Date Signature of Pump Installer

RECEIVED
 JUN 26 2013
 BY: OLWR

13 000