

no permit matched

County: Coahoma
Permit #: GW-4825T-48515
Driller: TEDDY Coats
Date drilling completed: 4-27-14

State Well Report
Part I - Driller's Log
Mississippi Department of Environmental Quality
Office of Land and Water Resources
P.O. Box 2309
Jackson, MS 39225
(601)961-5210
(601)961-5228 (fax)

For Office Use Only:
Aquifer: _____
Well #: B85
L.S. Elevation: _____
E-log #: _____

State Law requires that this report be prepared by the license holder responsible for the work and filed with the Department at the above address within 30 days of completion of drilling of the well or borehole.

Information on Well Owner (Landowner if borehole is not for a water well)	Well or Borehole Location
Owner Name: <u>MC Kee Brothers Trust</u>	Latitude: <u>34° 20' 40"</u> Longitude: <u>90° 36' 53"</u>
Mailing Address: <u>MC Kee Brothers Trust</u>	Method of Lat/Long (circle one): Conventional Survey.
<u>P.O. Box 17113</u>	USGS quad, Hand-held GPS, Survey-grade GPS
<u>Memphis, TN 38187</u>	<u>SE 1/4 NW 1/4 Sec 33 Twn 29N Rng 04W</u>
City: _____ State: _____ Zip Code: _____	Distance: <u>2</u> Miles Direction: <u>SE</u> of Nearest Town: <u>Farris Point</u>
Telephone No. (_____) _____	

Well / Borehole Data

Date drilling started: 4-27-14 Date drilling completed: 4-27-14 Hole depth: 115 Hole diameter: 28

Location of the source of any surface water used for drilling: Nearest well

Method of dosing and volume of Chlorine used in drilling and development: _____

Logs run (circle all applicable): (No log run) Electric Gamma Ray Density Sonic Neutron Other: _____

Name of organization running log(s): _____

Purpose of borehole (check one): Water Well Geotechnical/Geological Investigation _____ Ground Source Heat Pump _____

Seismic Survey _____ Other (describe) _____

If drilling is not related to water well construction, skip the remainder of this block

Purpose of Well (check one): Home _____ Industrial _____ Public Supply _____ Irrigation Fish Culture _____ Other: _____

If a flowing well, method of flow regulation: Valve _____ Other (describe) _____

Static Water Level: 20 feet above or below (circle one) land surface Date measured: 4-27-14

Method of Measurement (circle one) steel tape (electric tape) air line other: _____

Well depth: 115 Well grouted to a depth of 10 feet Type of grout (circle one): Neat Cement (Bentonite) Mix

Casing length: 75 feet Casing diameter: 16 inches Type of casing: PVC

Screen length: 40 feet Screen diameter: 16 inches Type of screen: PVC


Screen slot size: 0.50 inches Setting depth: From 0 feet to 70 feet

Type of completion (circle all applicable): (Gravel packed) Underreamed Telescoped Open hole Natural Development

Other (describe): _____

Top of lap pipe or reduction in casing: _____ feet. *If telescoped or more than one screen, describe on next page*

Handwritten notes and stamps at the bottom right of the page.

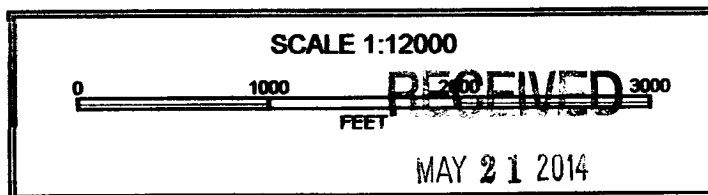

Mckee Bros
 Job # 14-0095

34 20 47.67N
 90 36 56.52W

BY OLWR

STATE WELL REPORT

Part 2

Pump Installer's Completion Report

Mississippi Department of Environmental Quality
Office of Land and Water Resources
P.O. Box 2309
Jackson, MS 39225-2309
(601)961-5210
(601) 360-0535 (fax)

For Office Use Only:

Well #: _____

Aquifer: _____

County: COAHOMA
 Permit #: GW-48215
 System: JOLTED WELL SERVICE
 Date completed: 4-27-14
 (Copy information from block on Part 1)

This part of the report must be completed by a licensed water well contractor or a licensed pump installer. A copy of Part 1 of the report must be attached and both parts filed with the Department at the above address within 30 days of well completion.

Well Owner Information	Well Location
Owner Name: <u>MCKEE BROTHERS TRUST</u>	Latitude: <u>34° 20' 41"</u> Longitude: <u>90° 36' 56"</u>
Mailing Address: <u>5872 RIDGEBEND RD</u>	Method of Lat/Long (check one): Conventional Survey _____, USGS quad _____, Hand-held GPS _____, Survey-grade GPS _____
<u>MEMPHIS</u> <u>TN</u> <u>38120</u>	<u>SE</u> 1/4 <u>NW</u> 1/4, Sec <u>33</u> T <u>29N</u> R <u>04W</u>
City State Zip Code	<u>1 1/2</u> Miles <u>SE</u> of <u>FRIARS POINT</u>
Telephone No. <u>(901) 680-7700</u>	(Distance) (Direction) (Nearest Town)

Pump Type (circle one)

Submersible Turbine Air Lift Centrifugal Flowing Well Jet Piston Rotary Other (describe): _____

Date Pump Installed: 4-28-14 Rated Pump Capacity: 1300 Gallons Per Minute

Is This Pump (circle one): New Repaired Replacement EXISTING

Power Type (circle one)

Electric Diesel Gasoline Natural Gas Tractor PTO Windmill Other (describe): _____

Horse Power Rating of Motor: 600 Setting Depth: 600 feet Number of Stages: 3

Pump Test Data for Non Flowing Well

Date Well Tested: _____ Duration of Pump Test (minimum 4 hours): _____ hours

Static Water Level (A): 20 Feet Below Land Surface Pumping Water Level (B): _____ Feet Below Land Surface

Drawdown [(B) - (A)]: _____ Feet Below Land Surface Test Pumping Rate: _____ Gallons Per Minute

Method of measurement (circle one): Steel tape Electric tape Air line Other (describe): _____

Pump Test Data for Flowing Well

Measured shut in head: _____ feet.

Well yielded _____ GPM with a drawdown of _____ feet after _____ hours of pumping

Meter Installation

Meter Manufacturer: N/A Meter Serial Number: _____

Meter Model Number/Name: _____ Type of Meter: _____


Totalizer Register Unit and Multiplier Factor (AF x .001, gal x 1000, etc): _____

Installation Date: _____ Meter installed by: _____

Is This Meter (circle one): New Repaired Replacement

Important: By submitting the above information you are certifying that this meter was installed to manufacturer standards. For agricultural wells, a list of approved meters is on the MDEQ website.

I HEREBY CERTIFY that the above statements are true to the best of my knowledge.

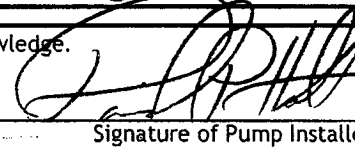DAVID P. HOLT 0-752P 5-12-14 

Print Name of Pump Installer and License No. (if applicable) Date Signature of Pump Installer

RECEIVED
MAY 21 2014
MDEQ

14-0085