

County: Coahoma
 Permit #: GW-48121
 Driller: Tommy Percock
 Date drilling completed: 12/14/14

STATE WELL REPORT

Part I

Driller's Log

Mississippi Department of Environmental Quality
 Office of Land and Water Resources
 P.O. Box 2309
 Jackson, MS 39225-2309
 (601)961-5210
 (601)360-0535 (fax)

For Office Use Only:
 Well #: B99
 Aquifer: _____
 E-log #: _____

State Law requires that this report be prepared by the license holder responsible for the work and filed with the Department at the above address within 30 days of completion of drilling of the well or borehole.

| Well Owner Information (Landowner if borehole is not for a water well) | Well or Borehole Location |
|---|---|
| Owner Name: <u>Charlie Craig</u> | Latitude: <u>34° 20' 31"</u> Longitude: <u>90° 35' 37"</u> |
| Mailing Address: <u>P.O. Box 129</u> | Method of Lat/Long (check one): Conventional Survey _____ |
| <u>Friars Point</u> MS <u>38631</u> | USGS quad _____, Hand-held GPS <input checked="" type="checkbox"/> , Survey-grade GPS _____ |
| City State Zip Code | <u>NE 1/4 SE 1/4, Sec 34 T 29N R 04W</u> |
| Telephone No. <u>(662) 902-7642</u> | <u>5</u> Miles <u>South</u> of <u>Friars Point</u> |
| | (Distance) (Direction) (Nearest Town) |

Well / Borehole Data

Date drilling started: 12/14/14 Date drilling completed: 12/14/14 Hole depth: 115' Hole diameter: 26"

Location of the source of any surface water used for drilling: interceptor ditch 1/2 mile East of well side

Method of dosing and volume of Chlorine used in drilling and development: chlorinated in tanker

Logs run (circle all applicable): No log run Electric Gamma Ray Density Sonic Neutron Other: _____

Name of organization running log(s): _____

Purpose of borehole (circle one): Water Well Geotechnical/Geological Investigation Ground Source Heat Pump Seismic Survey Other (describe): _____

If drilling is not related to water well construction, skip the remainder of this block

Purpose of Well (circle all applicable): Home Industrial Public Supply Irrigation Fish Culture

Other (describe): _____

If a flowing well, method of flow regulation: Valve _____ Other (describe): _____

Static Water Level: _____ feet (above or below) land surface Date measured: _____
 (circle one)

Method of measurement (circle one): Steel tape Electric tape Air line Other (describe): _____

Well depth: 115 Well grouted to a depth of: 10 feet Type of grout (circle one): Heat Cement Bentonite Mix

Casing length: 75 feet Casing diameter: 16 inches Type of casing: PVC

Screen length: 40 feet Screen diameter: 16 inches Type of screen: PVC

Screen slot size: .050 inches Setting depth: From 75 feet to 115 feet


Type of completion (circle all applicable): Gravel packed Underreamed Open hole Natural Development

Other (describe): _____

Top of lap pipe or reduction in casing: _____ feet

If telescoped or more than one screen, describe on next page

RECEIVED
 DEC 23 2014
 BY: OLWR

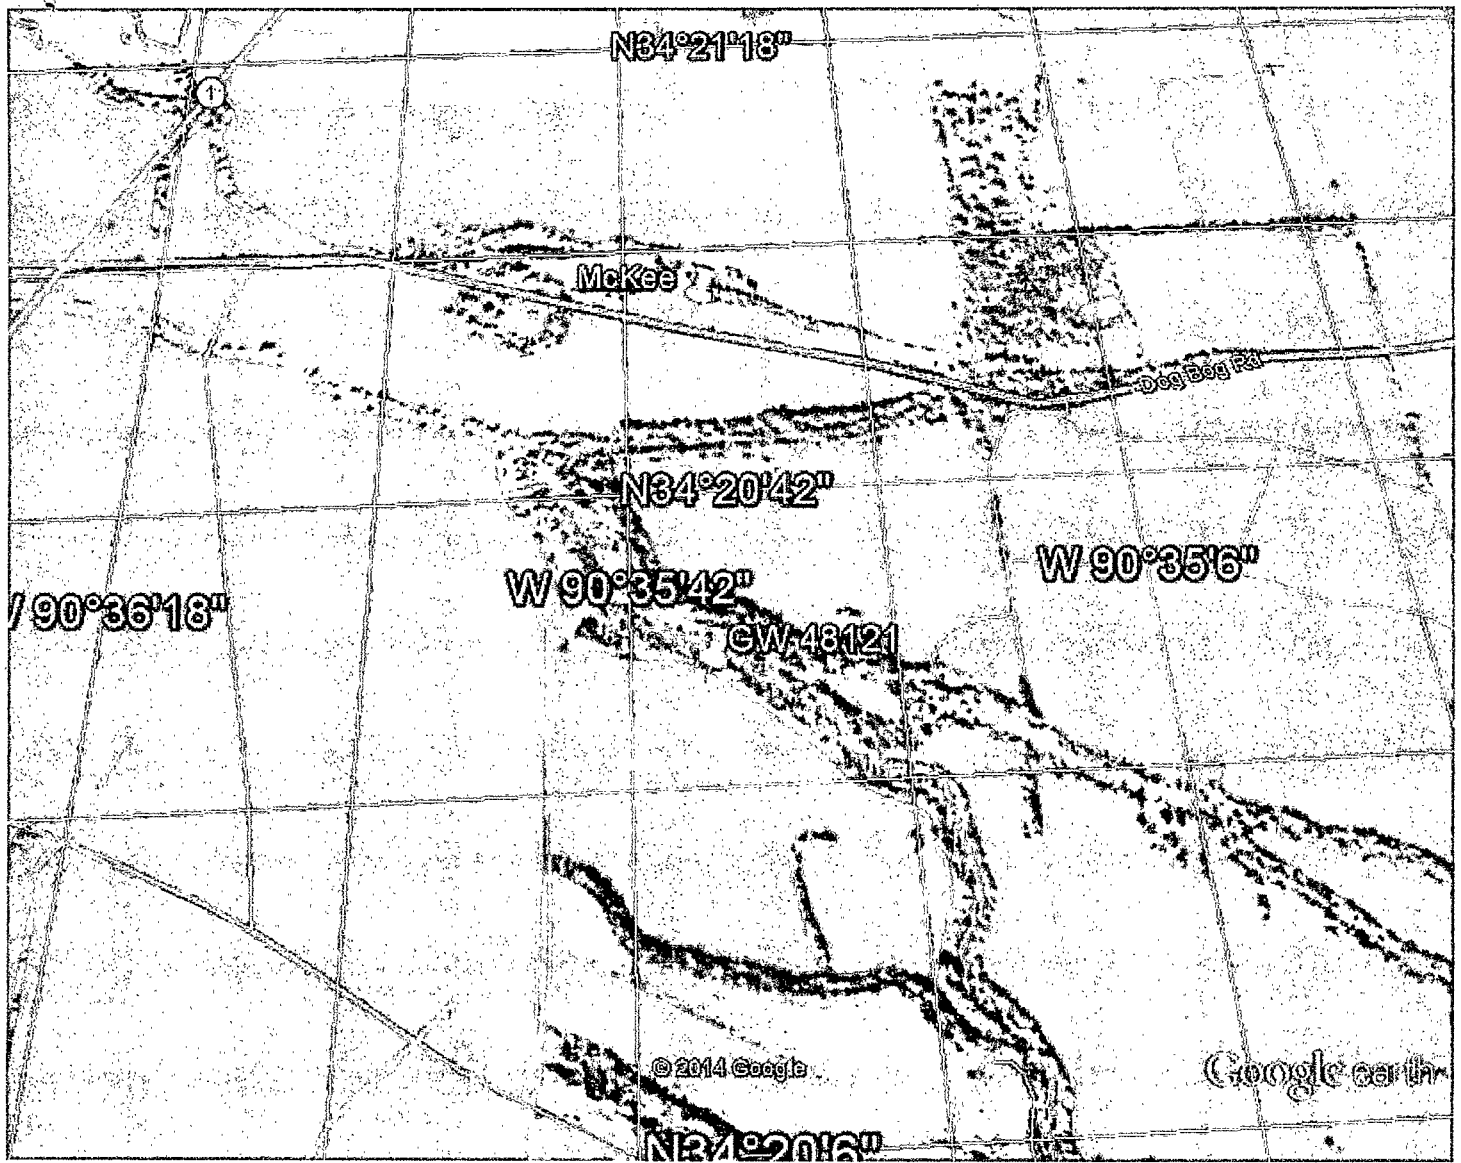

Google earth



RECEIVED

DEC 23 2014

BY: OLWR



Dean A. Pennington,
Executive Director
P. O. Box 129
Stoneville, MS 38771
Tel.: (662) 686-7712
Fax: (662) 686-9078
www.ymd.org

Yazoo Mississippi Delta Joint Water Management District

April 7, 2014

CHARLIE CRAIG
P. O. BOX 129
FRIARS POINT, MS 38631

662 902 7642

16" PVC

Handwritten mark

RE: Well Construction/Authorization to drill

Permit No: GW-48121

DEAR CHARLIE CRAIG:

This authorization letter is for the construction of a new well that is to be drilled in the Mississippi River Valley Alluvial Aquifer. Your application has been received and is currently being processed.

Location: NE1/4 of the SE1/4 Section 34 Township 29N Range 04W County COAHOMA
Latitude: 34 20 22 Longitude: 90 35 23

31 37

A copy of this notice or a water use permit **must be** attached to the State Well Report submitted by your driller. This report is a requirement of the State Well Drillers Regulation. A copy of this report **must be** mail or faxed to YMD Joint Water Management District.

All applications must meet the **Mississippi Department of Environmental Quality** rules and regulations. If no adverse comments are received the application will be presented to the Mississippi Department of Environmental Quality State Permit Board for approval.

If you have any questions please call YMD at 662/686-7712.

Sincerely,

Dillard Melton Jr.

Dillard Melton Jr.
Permitting Director

RECEIVED

DEC 23 2014

BY: OLWR