

COAHOMA MISSISSIPPI BOARD OF WATER COMMISSIONERS

C 15

3-22-62

WATER WELL DRILLERS LOG

CODED

Date: 3/22, 1962, Driller: Line County, Jones County, Coahoma
(Name)

(1) Owner of Land	Description & Color of Materials Sand, Clay, Red Clay, Shell, etc.	Thick- ness Feet	Depth Feet
<u>M. M. Butler</u> (Name) <u>Jonestown, Miss</u> (Address)	Clay	32	32
(2) Location: $\frac{1}{4}$, $\frac{1}{4}$, Sec. <u>24 T29R30</u>	Fert Sand	7	39
<u>3</u> miles <u>N-NE</u> of <u>Jonestown</u> (distance) (direction) (Nearest Town)	Clay	12	51
(3) Topography: <u>Flat</u> (Hilly) (Flat) (Level)	Copper sand		
(4) Purpose of Well: <u>irrigation</u> (Domestic Irrigation Municipal, Industrial, Other)	Des. Stone	54	105

Information upon completion of well:


- (1) Diameter 6 inches.
- (2) Total Depth 105 feet.
- (3) Water Level 18 feet below top of ground.
- (4) Cased to 57', Size 6"
- (5) Screen: Size 6", Length 48
- (6) Were any formations sealed against pollution?
no

If YES depth of formation _____

Why _____

Drillers Remarks: _____

1700 G.P. 101

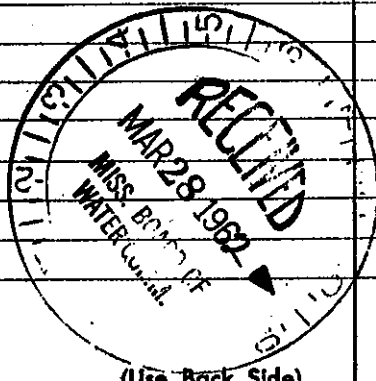

(Use Back Side)

Well No. _____

Mail this copy to Board of Water Commissioners 429 Miss. St. Jackson, Miss