

Coahoma  
C 16  
8-67

MISSISSIPPI  
BOARD OF WATER COMMISSIONERS  
416 North State Street  
Jackson, Mississippi 39201

**CODED**

C 2433

WATER WELL DRILLERS LOG

August 9, 19 67 Layne-Central Company Coahoma  
date well completed firm name county well located

LANDOWNER: Coahoma County Schools

Hull School

Coahoma, Mississippi

(mailing address)

WELL LOCATION:

sec. 21 T 29 N R. 3 E

miles at of Coahoma  
(distance) (direction) (nearest town)

WELL PURPOSE: Domestic  
(home, irrigation, municipal, industrial)


WELL COMPLETION DATA:

- (1) diameter (inches) 6x3
- (2) total depth (feet) 1101'5"
- (3) static water level (feet) 7' below top of ground.
- (4) casing steel, 200' (material), (depth)  
28' 7" lap  
6" If telescope see back. (size)
- (5) screen 40' 5", 1053' 2" (length), (depth to top)  
8' 3" tail pipe (size) 3", Southwest (material)
- (6) pump 5 50 (HP) (yield gpm)  
electric (type power)
- (7) electric log no (yes or no)  
(organization running log)
- (8) how well bottom plugged 75 lbs. shot

Description of formations encountered

Description of formations encountered	from	to
Clay	10	11
Brown sand	11	30
Sand	30	48
Coarse sand	48	80
Coarse sand & pea gravel	80	115
Coarse sand & gravel	115	137
Clay	137	193
Sand	193	210
Clay	210	240
Sand	240	435
Clay	435	495
Sand	495	540
Clay	540	743
Rock	743	745
Clay	745	760
Rock	760	762
Hard shale	762	930
Sandy shale	930	950
Sable	950	1028
Sand & sandy shale	1028	1039
Sand	1039	1089
Sandy shale	1089	1101

**CODED**

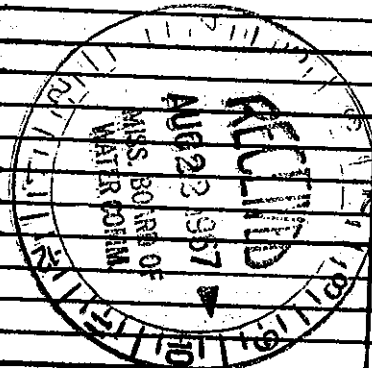

DRILLERS REMARKS: