

COAHOMA MISSISSIPPI BL.

C 24

5-18-62

WATER WELL DRILLERS LOG

CODED

Date: 5/18, 1962, Driller: FIVE COUNTY FARMERS ASS'N. County Coahoma
(Name)

(1) Owner of Land:	Description & Color of Materials Sand, Clay, Red Clay, Shell, etc.	Thick- ness Feet	Depth Feet
<u>M. M. Butler</u> (Name) <u>Rich Miss</u> (Address) <u>19 29 2</u>	<u>clay</u> <u>fine sand</u>	<u>42</u>	<u>42</u>
(2) Location: <u>NE 1/4, NE 1/4, Sec. 13 (29) 29 3N</u> <u>1</u> miles <u>South</u> of <u>Rich</u> (distance) (direction) (Nearest Town)	<u>Clay Sand</u> <u>Red Brown</u>	<u>7</u>	<u>49</u>
(3) Topography: <input checked="" type="checkbox"/> (Level) (Hilly) (Flat)			
(4) Purpose of Well: <u>irrigation</u> (Domestic Irrigation Municipal, Industrial, Other)			

Information upon completion of well:


- (1) Diameter 6 inches.
- (2) Total Depth 97 feet.
- (3) Water Level 21 feet below top of ground.
- (4) Cased to 49, Size 6.
- (5) Screen: Size 6, Length 48.
- (6) Were any formations sealed against pollution?
_____ yes, no.

If YES depth of formation _____

Why _____

Drillers Remarks: _____

CODED

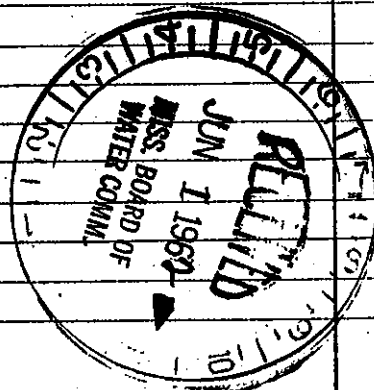

(Use Back Side)

Well No. _____

Mail this copy to Board of Water Commissioners 429 Miss. St. Jackson, Miss.