

State Well Report

Part 1

Mississippi Department of Environmental Quality
Office of Land and Water Resources
P.O. Box 10631
Jackson, MS 39289-0631
(601)961-5210
(601)354-6938 (fax)

For Office Use Only:

Aquifer: _____
Well #: C124
L. S. Elevation: _____
E-log #: _____

County: Coahoma
Permit #: 0W41658
Irrigation Equipment
Driller: _____
Date drilling completed: 7-14-06

State Law requires that this report be prepared by the driller in detail and filed with the Department within 30 days of completion of drilling of the well.

Well Owner Information	Well Location
Owner Name: <u>Antici Farms</u>	Latitude: <u>34 23 21.3</u> Longitude: <u>90 27 44.0</u>
Mailing Address: <u>203 Porter Drive</u>	Method of Lat/Long (circle one): <u>Conventional Survey</u>
<u>Clarksdale MS 38614</u>	<u>NE</u> USGS quad, Hand-held GPS, Survey-grade GPS <u>NW</u> <u>NW</u> 1/4 Sec <u>13</u> Twn <u>29N</u> Rng <u>3W</u>
City State Zip Code	Distance Direction Nearest Town <u>3</u> Miles <u>SW</u> of <u>Rich</u>
Telephone No. () _____	

Well Data

Purpose of Well (circle one) Home Industrial Public Supply Irrigation Fish Culture Other: _____

Date well drilling started: 7-14-06 Date well drilling completed: 7-14-06

If flowing, method of flow regulation: Valve _____ Other (describe) _____

Static Water Level: 22' feet above or below (circle one) land surface Date measured: 7-14-06

Method of Measurement (circle one) steel tape electric tape air line other: _____

Hole depth: 122 Well depth: 122' Well grouted to a depth of 10 feet

Type of grout (circle one): Cement Bentonite Mix

Casing length: 82 feet Casing diameter: 10" inches Type of casing: PVC

Screen length: 40 feet Screen diameter: 10 inches Type of screen: PVC

Screen slot size: .050 inches Setting depth: From 83 feet to 122 feet

Type of completion (circle all applicable): Gravel packed Underreamed Telescoped Open hole Natural Development

Other (describe): _____

Top of lap pipe or reduction in casing: _____ feet. If telescoped or more than one screen, describe on back of page

Logs run (circle all applicable): No log run Electric Gamma Ray Density Sonic Neutron Other: _____

Name of organization running log(s): _____

I certify that the well was drilled, constructed, and completed in accordance with all applicable requirements of the Mississippi Department of Environmental Quality and/or the Mississippi Department of Health regulations and state laws.

Irrigation Equipment Inc.
Patrick M. Chism 0695

Print Name of Water Well Contractor and License No. _____ Signature of Water Well Contractor Patrick M Chism

RECEIVED

APR 17 2007

YMD JOINT WATER
BOARD OF DIRECTORS

41658

State Well Report

Part 1

Mississippi Department of Environmental Quality
 Office of Land and Water Resources
 P.O. Box 10631
 Jackson, MS 39289-0631
 (601)961-5210
 (601)354-6938 (fax)

County: Coahoma
 Permit #: GW 41658
 Irrigation Equipment
 Driller:
 Date drilling completed: 7-14-06

For Office Use Only:
 Aquifer:
 Well #: C-124
 L. S. Elevation:
 E-log #:

State Law requires that this report be prepared by the driller in detail and filed with the Department within 30 days of completion of drilling of the well.

Well Owner Information	Well Location
Owner Name: <u>Antici Farms</u>	Latitude: <u>34 23 21.3</u> , Longitude: <u>90 27 44.0</u>
Mailing Address: <u>203 Porter Drive</u>	Method of Lat/Long (circle one): <u>Conventional Survey</u> , <u>NE</u> USGS quad, Hand-held GPS, Survey-grade GPS
<u>Clarksdale MS 38614</u>	<u>NW</u> 1/4 <u>NW</u> 1/4 Sec <u>13</u> Twn <u>29N</u> Rng <u>3W</u>
City State Zip Code	Distance <u>3</u> Miles Direction <u>SW</u> of Nearest Town <u>Rich</u>
Telephone No. ()	

Well Data

Purpose of Well (circle one) Home Industrial Public Supply Irrigation Fish Culture Other: _____

Date well drilling started: 7-14-06 Date well drilling completed: 7-14-06

If flowing, method of flow regulation: Valve _____ Other (describe) _____

Static Water Level: 22' feet above or below (circle one) land surface Date measured: 7-14-06

Method of Measurement (circle one) steel tape electric tape air line other: _____

Hole depth: 122 Well depth: 122' Well grouted to a depth of 10 feet

Type of grout (circle one): Cement Bentonite Mix

Casing length: 82 feet Casing diameter: 10" inches Type of casing: PVC

Screen length: 40 feet Screen diameter: 10 inches Type of screen: PVC

Screen slot size: .050 inches Setting depth: From 83 feet to 122 feet

Type of completion (circle all applicable): Gravel packed Underreamed Telescoped Open hole Natural Development

Other (describe): _____

Top of lap pipe or reduction in casing: _____ feet. If telescoped or more than one screen, describe on back of page

Logs run (circle all applicable): No log run Electric Gamma Ray Density Sonic Neutron Other: _____

Name of organization running log(s): _____

I certify that the well was drilled, constructed, and completed in accordance with all applicable requirements of the Mississippi Department of Environmental Quality and/or the Mississippi Department of Health regulations and state laws.

Irrigation Equipment Inc.
Patrick M. Chism 0695

Print Name of Water Well Contractor and License No. Patrick M Chism
 Signature of Water Well Contractor

RECEIVED
 JUL 31 2006
 BY: OLWR


If well telescopes please sketch below and show depths.

Ground Level

Description of Formations Encountered	From	To
Clay	0	35
Fine Sand	36	65
Med. Sand/gravel	66	122

If more than one screen, show location of each on sketch

Sketch the property layout and include the following: 1) the well location; 2) any permanent structures on the property that may aid in locating the well; 3) any roads, power lines, or other items that may aid in locating the property and the well; 4) indicate direction.

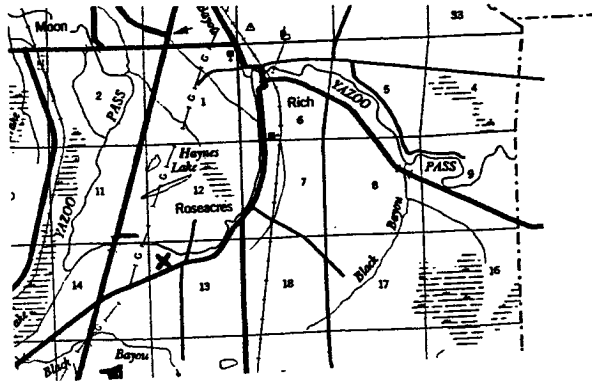

Landowner Name: _____

Patricia M. Clark
Signature of Water Well Contractor

STATE WELL REPORT

Part 2

Pump Installer's Completion Report
 Mississippi Department of Environmental Quality
 Office of Land and Water Resources
 P.O. Box 10631
 Jackson, MS 39289-0631
 (601)961-5210
 (601)354-6938 (fax)

County: Coahoma
 Permit #: 6W41658
 Irrigation Equipment
 Driller: _____
 Date completed: 7-14-06
Copy information from block on Part 1

For Office Use Only:

Aquifer: _____
 Well #: C-124
 Elevation: _____

This part of the report must be completed by a licensed water well contractor or a licensed pump installer. A copy of Part 1 of the report must be attached and both parts filed with the Department at the above address within 30 days of well completion.

Well Owner Information	Well Location
Owner Name: <u>Antici Farms</u>	Latitude: _____ Longitude: _____
Mailing Address: <u>203 Porter Drive</u>	Method of Lat/Long (check one): Conventional Survey _____
<u>Clarksdale MS 38614</u>	USGS quad _____, Hand-held GPS _____, Survey-grade GPS _____
City State Zip Code	<u>NW ¼ NW ¼ Sec 13 T 29N R 3W</u>
Telephone No. () _____	Distance Direction Nearest Town
	<u>3 Miles SW of Rich</u>

Pump Type Circle one	Power Type Circle one
Air Lift Jet <input type="radio"/> <u>Submersible</u> <input checked="" type="radio"/>	Diesel Engine Gasoline Engine Natural Gas
Bucket Piston <input type="radio"/> Turbine <input type="radio"/>	<u>Electric Motor</u> <input checked="" type="radio"/> Hand <input type="radio"/> Tractor PTO <input type="radio"/>
Centrifugal Rotary <input type="radio"/> Flowing Well <input type="radio"/>	Windmill Other (specify): _____
Other (specify): _____	Horse Power Rating of Motor: <u>15</u>
Date Pump Installed: <u>7-14-06</u>	Setting Depth: <u>70</u> feet
Rated Pump Capacity: <u>750</u> Gallons Per Minute	Number of Stages: <u>1</u>

Pump Test Data	Method of Measuring Water Level Circle one
Date Well Tested: _____	Air Line Electric Measuring Line Steel Tape
Static Water Level (A): _____ Feet Below Land Surface	Other (specify): _____
Pumping Water Level (B): _____ Feet Below Land Surface	For flowing well, measured shut in head: _____ feet
Drawdown [(B) - (A)]: _____ Feet Below Land Surface	Well yielded _____ GPM with a drawdown of _____ feet after _____ hours of pumping
Test Pumping Rate: _____ Gallons Per Minute	
Duration of Pump Test (minimum 4 hours): _____ hours	

I HEREBY CERTIFY that the above statements are true to the best of my knowledge.
 Patrick M. Chism 0695
 Print Name of Pump Installer and License No. (if applicable) Patrick M Chism
 Signature of Pump Installer

RECEIVED
 Form: OLWRS-10/05

JUL 31 2006

BY: OLWR