

Job. #8264

County: Coahoma
 Permit #: _____
 Driller: Pete Sappington
 Date drilling completed: 1-15-09

State Well Report
Part I - Driller's Log
 Mississippi Department of Environmental Quality
 Office of Land and Water Resources
 P.O. Box 2307
 Jackson, MS 39225
 (601)961- 5210
 (601)961- 5228 (fax)

For Office Use Only:
 Aquifer: _____
 Well #: C131
 L. S. Elevation: _____
 E-log #: _____

State Law requires that this report be prepared by the license holder responsible for the work and filed with the Department at the above address within 30 days of completion of drilling of the well or borehole.

<p>Information on Well Owner (Landowner if borehole is not for a water well)</p> <p>Owner Name: <u>Charles Andici Farms</u> Mailing Address: <u>203 Parter Dr.</u> <u>Clarksdale, MS 38614</u> City State Zip Code Telephone No. <u>662-624-8836</u></p>	<p>Well or Borehole Location</p> <p>Latitude: <u>34.21.989</u> Longitude: <u>90.27.804</u> 59 46 Method of Lat/Long (circle one): Conventional Survey, USGS quad <u>Hand-held GPS</u>, Survey-grade GPS <u>SE 1/4 SW 1/4 Sec 24 Twn 29N Rng 3W</u> Distance Direction Nearest Town <u>3 Miles SW of Rich, MS</u></p>
--	---

Well / Borehole Data

Date drilling started: 1-15-09 Date drilling completed: 1-15-09 Hole depth: 100' Hole diameter: 28"

Location of the source of any surface water used for drilling: Ditch Beside Well
 Method of dosing and volume of Chlorine used in drilling and development: Sodium hypochlorite @ 10 ppm

Logs run (circle all applicable): (No log run) Electric Gamma Ray Density Sonic Neutron Other: _____
 Name of organization running log(s): _____

Purpose of borehole (check one): Water Well Geotechnical/Geological Investigation _____ Ground Source Heat Pump _____
 Seismic Survey _____ Other (describe) _____
If drilling is not related to water well construction, skip the remainder of this block

Purpose of Well (check one): Home _____ Industrial _____ Public Supply _____ Irrigation _____ Fish Culture _____ Other: _____

If a flowing well, method of flow regulation: Valve _____ Other (describe) _____

Static Water Level: 24 foot above or below (circle one) land surface Date measured: 1-15-09

Method of Measurement (circle one) (steel tape) electric tape air line other: _____

Well depth: 100 Well grouted to a depth of 10 feet Type of grout (circle one): Neat Cement (Bentonite) Mix

Casing length: 60 foot Casing diameter: 12 inches Type of casing: PVC

Screen length: 40 feet Screen diameter: 12 inches Type of screen: PVC

Screen slot size: 1032 inches Setting depth: From 60 feet to 180 feet

Type of completion (circle all applicable): (Gravel packed) Underreamed Telescoped Open hole Natural Development
 Other (describe): _____

Top of lap pipe or reduction in casing: _____ feet. *If telescoped or more than one screen, describe on next page*

License # 0430
Pete Sappington

Pete's Well Drilling

Form: OLWR 888-1A (04/02)
RECEIVED
 FEB 17 2009
 BY: OLWR

Ground Level


Description of Formations Encountered

From To

Mud/Clay	0	22
Fine Sand	22	28
Coarse Sand/Gravel	28	100

If more than one screen, show location of each on sketch

Sketch the property layout and include the following: 1) the well location; 2) any permanent structures on the property that may aid in locating the well; 3) any roads, power lines, or other items that may aid in locating the property and the well; 4) indicate direction.

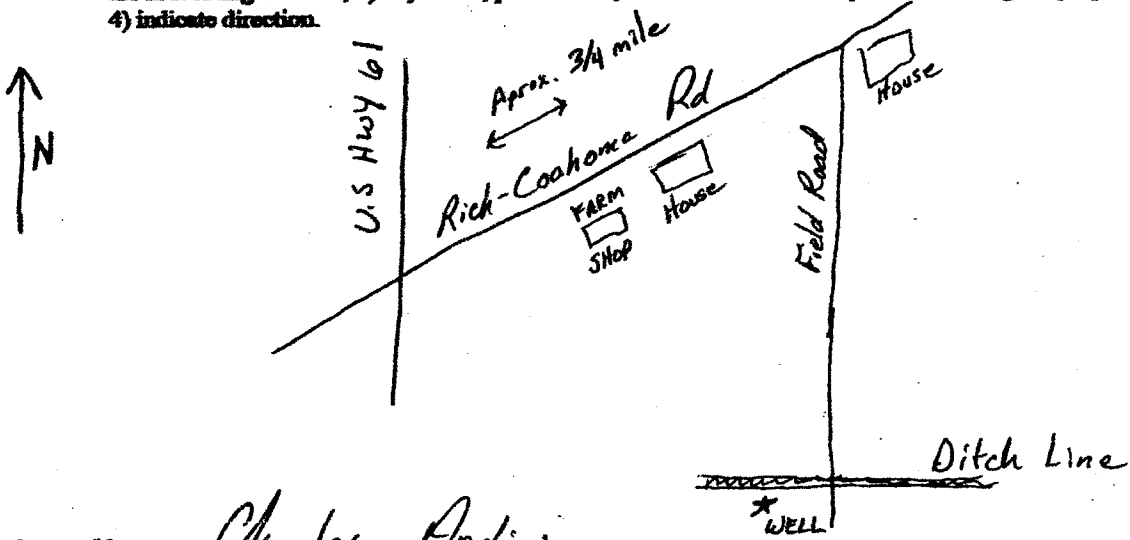

Landowner Name: Charles Andici


Signature of Water Well Contractor

RECEIVED
FEB 17 2009
BY: OLWR

STATE WELL REPORT

Part 2

Pump Installer's Completion Report
 Mississippi Department of Environmental Quality
 Office of Land and Water Resources
 P.O. Box 10631
 Jackson, MS 39289-0631
 (601)961-5210
 (601)354-6938 (fax)

County: Coahoma
 Permit #: _____
 Driller: PETE SAPPINGTON
 Date completed: 1-15-09
Copy information from block on Part 1

For Office Use Only:

Aquifer: _____
 Well #: C-131
 Elevation: _____


This part of the report must be completed by a licensed water well contractor or a licensed pump installer. A copy of Part 1 of the report must be attached and both parts filed with the Department at the above address within 30 days of well completion.

Well Owner Information	Well Location
Owner Name: <u>Charles Antici Farms</u>	Latitude: <u>34° 21' 59.2"</u> Longitude: <u>90° 27' 45.7"</u>
Mailing Address: <u>203 PORTER DR</u>	Method of Lat/Long (check one): Conventional Survey <input checked="" type="checkbox"/> ⁵⁹ ₉₆
<u>CLARKSDALE MS 38614</u>	USGS quad _____, Hand-held GPS _____, Survey-grade GPS _____
City State Zip Code	_____ 1/4 _____ 1/4 Sec <u>24</u> T <u>29N</u> R <u>3W</u>
Telephone No. <u>(601) 624-8836</u>	Distance Direction Nearest Town <u>3 1/2</u> Miles <u>SSW</u> of <u>RICH</u>

Pump Type Circle one	Power Type Circle one
Air Lift Jet Submersible	<input checked="" type="radio"/> Diesel Engine Gasoline Engine Natural Gas
Bucket Piston <input checked="" type="radio"/> Turbine	Electric Motor Hand Tractor PTO
Centrifugal Rotary Flowing Well	Windmill Other (specify): _____
Other (specify): _____	Horse Power Rating of Motor: <u>40</u>
Date Pump Installed: <u>1-19-09</u>	Setting Depth: <u>70</u> feet
Rated Pump Capacity: <u>11000</u> Gallons Per Minute	Number of Stages: <u>2</u>

Pump Test Data	Method of Measuring Water Level Circle one
Date Well Tested: _____	Air Line Electric Measuring Line <input checked="" type="radio"/> Steel Tape
Static Water Level (A): <u>24</u> Feet Below Land Surface	Other (specify): _____
Pumping Water Level (B): _____ Feet Below Land Surface	For flowing well, measured shut in head: _____ feet
Drawdown [(B) - (A)]: _____ Feet Below Land Surface	Well yielded _____ GPM with a drawdown of _____ feet after _____ hours of pumping
Test Pumping Rate: _____ Gallons Per Minute	
Duration of Pump Test (minimum 4 hours): _____ hours	

I HEREBY CERTIFY that the above statements are true to the best of my knowledge.

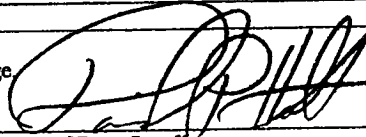David P. Holt 0-752P 
 Print Name of Pump Installer and License No. (if applicable) Signature of Pump Installer

Form: OLWR-SWR-1B

RECEIVED
 FEB 17 2009
 BY: OLWR

JOB
 8264