	State W	all Danart		
C \	State Well Report		For Office Use Only:	
County: Coahoma	Part 1 — <b>Driller's Log</b> Mississippi Department of Environmental Quality		Aquifer:	
Permit #: <u>GW-46977</u>	Office of Land and Water Resources		well#: CIA6	
	P.O. Box 2309			
1	Jackson, MS 39225		L. S. Elevation:	
Date drilling completed: 3-10-13	(601)961- 5210 (601)961- 5228 (fax)		r to the	
	` '		E-log #:	
State Law requires that this report be prepared by the license holder responsible for the work and filed with the Department at the above address within 30 days of completion of drilling of the well or borehole.				
Information on Well Owner Well or Borehole Location				
			_	
Owner Name Bellview Planting (a) Mailing Address: Po Box 504  Latitude: 35  Method of L  USGS		Latitude: 57 ° JI 'JS.	17 Longitude: 90 ° 30 '9.29"	
		Method of Lat/Long (circle one): Conventional Survey,		
		USGS quad, Hand-held GPS Survey-grade GPS		
7	201110	NEW SE 14 Sec 28	Twn 29N Rng 03W	
Lyon /US	38043	NW SW 21		
City State Zip Code		Distance Direction Nearest Town  Miles E of Councina		
Telephone No. ()		TATION -		
		Lala Data		
Well / Borchole Data				
Date drilling started: 3-10-13 Date drilling completed: 3-10-13 Hole depth: 120 Hole diameter: 28 in				
Location of the source of any surface water Method of dosing and volume of Chlorine	used for drilling:	envest well		
Logs run (circle all applicable): No log run Name of organization running log(s):	Electric Gamma Ray	Density Sonic Neutron	Other:	
Purpose of borehole (check one): Water We	II & Gastachnical/Gasta	raical Investigation Ground	Source Heat Pump	
•			Course Hour Family	
Seismic Survey Other (describe)				
If drilling is not related to water well construction, skip the remainder of this block				
Purpose of Well (check one): Home Industrial Public Supply Irrigation Fish Culture Other:				
If a flowing well, method of flow regulation: Valve Other (describe)				
Static Water Level: 26 feet above or below (circle one) land surface Date measured: 3-10-13				
Method of Measurement (circle one) steel tape electric tape air line other:				
Well depth: Well grouted to a depth of 10 feet Type of grout (circle one): Neat Cement Bentonite Mix				
Casing length: 60 feet Casing	1.2	_inches Type of casing:		
Screen length: 40 feet Screen	1 .	_inches Type of screen:	puc	
Screen slot size:	Setting depth: From	& 80 feet to	120 feet	
Type of completion (circle all applicable): (			hole Natural Development	
	Other (describe):			
To a Character or and retire in accions	Fant If tal	sconed or more than one care	on describe on next nage	
Top of lap pipe or reduction in casing:	ieet. <u>if tele</u>	<u>scopeu or more inun one scree</u>	m, describe on next page	

Form: OLWR-SWF RE44 VED




#### The sketch below only required for water wells

If well telescopes, show depths on sketch.

## Description of formations encountered must be provided for all wells and boreholes, unless specifically exempted by regulations

n (depth) ound Level SO UD (DO SO JOO	13.0
90 (40 80 80	40 80
80	13-0
80	13-0
100 \$0	13-0
100	150
	1
	<del></del>
	<u> </u>
	L

If more than one screen, show location of each on sketch

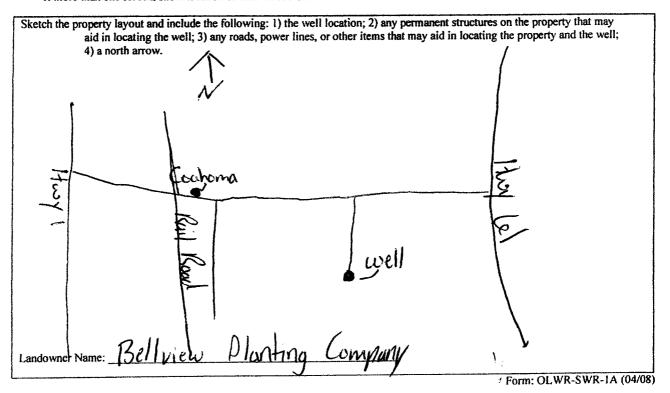

I certify that the well/borehole was drilled, constructed, and completed in accordance with all applicable requirements of the Mississippi Department of Environmental Quality and the Mississippi Department of Health regulations, if applicable, and state

laws.


| Sel Jumper 5317
| Print Name of Responsible Licensee and License No.


3-10-13

Date

Signature of Licensee MAR

BY: OLWR

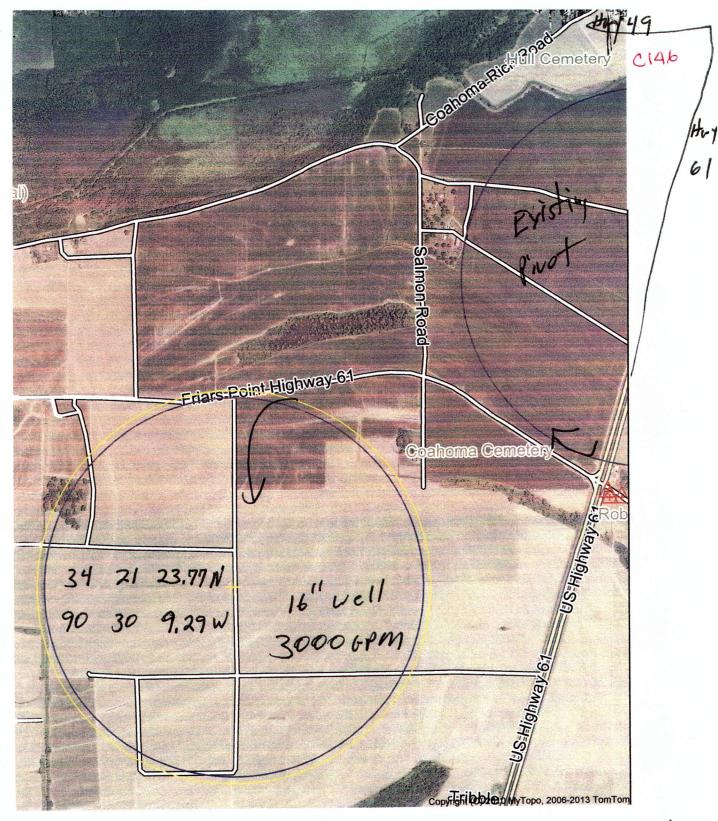

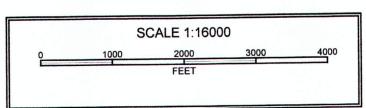

Bellview Planting
(0.
TOS# RECEIVED

MAR 2 5 2013

BY: OLWR

### STATE WELL REPORT

# Permit #: GW- 46977 Driller: JOEL Junger Date completed: 3-10-13 Copy information from block on Part 1

### Part 2

### Pump Installer's Completion Report

Mississippi Department of Environmental Quality
Office of Land and Water Resources
P.O. Box 2309
Jackson, MS 39225-2309
(601)961-5210

For Office Use Only:			
Well #:			
Aquifer:			

(601) 360-0535 (fax) This part of the report must be completed by a licensed water well contractor or a licensed pump installer. A copy of Part 1 of the report must be attached and both parts filed with the Department at the above address within 30 days of well completion. Well Owner Information Well Location Latitude: 34. 21. 23" Longitude: 90.30.09" BELLUCEW PLTG CO Owner Name: Mailing Address: P.O. Box 504 Method of Lat/Long (check one): Conventional Survey\_\_\_ USGS quad\_\_\_\_\_, Hand-held GPS\_\_\_\_\_, Survey-grade GPS\_ LYON MS City State Zip Code COAHOMA Telephone No. (662) (Distance) (Direction) (Nearest Town) Pump Type (circle one) Submersible (Turbine) Air Lift Centrifugal Flowing Well Jet Piston Rotary Other (describe): \_\_\_\_ 4-30 - 13 Rated Pump Capacity: 3000 Gallons Per Minute Date Pump Installed: Is This Pump (circle one): New Repaired Replacement Power Type (circle one) Electric Diesel Gasoline Natural Gas Tractor PTO Windmill Other (describe): \_\_\_\_ Horse Power Rating of Motor: \_\_\_ 200 Setting Depth: \_feet Number of Stages: Pump Test Data for Non Flowing Well Date Well Tested: \_\_\_\_\_ Duration of Pump Test (minimum 4 hours): \_\_\_\_\_ hours Static Water Level (A): \_\_\_\_\_ Feet Below Land Surface Pumping Water Level (B): \_\_\_\_\_ Feet Below Land Surface Method of measurement (circle one): Steel tape) Electric tape Air line Other (describe):\_\_\_\_\_ Pump Test Data for Flowing Well Measured shut in head: \_\_\_\_\_feet. Well yielded \_ \_GPM with a drawdown of \_\_\_ \_\_\_\_\_\_ feet after \_\_\_\_\_\_hours of pumping Meter Installation Meter Manufacturer: \_\_\_\_ \_\_\_\_\_ Meter Serial Number: \_\_\_\_\_ Meter Model Number/Name: \_\_\_\_\_ Type of Meter: Totalizer Register Unit and Multiplier Factor (AF x .001, gal x 1000, etc):\_\_\_\_\_ Installation Date: \_\_\_\_\_ Meter installed by: \_\_\_\_ Is This Meter (circle one): New Repaired Replacement Important: By submitting the above information you are certifying that this meter was installed to manufacturer standards. For agricultural wells, a list of approved meters is on the MDEQ website. I HEREBY CERTIFY that the above statements are true to the best of my knowledge. Print Name of Pump Installer and License No. (if applicable) Signature of Pump Installer

Form: OLWR-SWR-1B (4/13)

3.00