

### STATE WELL REPORT

#### Part 1

#### Driller's Log

Mississippi Department of Environmental Quality  
 Office of Land and Water Resources  
 P.O. Box 2309  
 Jackson, MS 39225-2309  
 (601)961-5210  
 (601)360-0535 (fax)

#### For Office Use Only:

Well #: C152  
 Aquifer: \_\_\_\_\_  
 E-Log #: \_\_\_\_\_

County: Cochran  
 Permit #: BW-47934 ✓  
 Driller: Clarence McMurry  
 Date drilling completed: 6-26-14

State Law requires that this report be prepared by the license holder responsible for the work and filed with the Department at the above address within 30 days of completion of drilling of the well or borehole.

<b>Well Owner Information</b> #2026 (Landowner if borehole is not for a water well) Owner Name: <u>Clark and Clark</u> Mailing Address: <u>6245 Lenox Central Court</u> <u>Memphis</u> TN <u>38115</u> City State Zip Code Telephone No. <u>(602) 902-3391</u>		<b>Well or Borehole Location</b> Latitude: <u>34°20'42.02"</u> Longitude: <u>90°27'16.10"</u> Method of Lat/Long (check one): Conventional Survey _____ USGS quad _____, Hand-held GPS <u>Y</u> , Survey-grade GPS _____ <u>SE 1/4 NE 1/4, Sec 36 T 29N R 03W</u> _____ Miles _____ of _____ (Distance) (Direction) (Nearest Town)	
--	--	--	--

**Well / Borehole Data**

Date drilling started: 6-26-14 Date drilling completed: 6-26-14 Hole depth: 125' Hole diameter: 26"

Location of the source of any surface water used for drilling: Ditch 200' away

Method of dosing and volume of Chlorine used in drilling and development: \_\_\_\_\_

Logs run (circle all applicable): NO LOG RUN Electric Gamma Ray Density Sonic Neutron Other: \_\_\_\_\_

Name of organization running log(s): \_\_\_\_\_

Purpose of borehole (circle one): Water Well Geotechnical/Geological Investigation Ground Source Heat Pump  
 Seismic Survey Other (describe) \_\_\_\_\_

*If drilling is not related to water well construction, skip the remainder of this block*

Purpose of Well (circle all applicable): Home Industrial Public Supply Irrigation Fish Culture

Other (describe): \_\_\_\_\_

If a flowing well, method of flow regulation: Valve \_\_\_\_\_ Other (describe) \_\_\_\_\_

Static Water Level: \_\_\_\_\_ feet (above or below) and surface Date measured: \_\_\_\_\_  
 (circle one)

Method of measurement (circle one): Steel tape Electric Log Air line Other (describe): \_\_\_\_\_

Well depth: 125' Well grouted to a depth of: 10 feet Type of grout (circle one): Neat Cement Bentonite Mix

Casing length: 75' feet Casing diameter: 16 inches Type of casing: PVC

Screen length: 50 feet Screen diameter: 16 inches Type of screen: PVC

Screen slot size: .050 inches Setting depth. From 75' feet to 125' feet

Type of completion (circle all applicable): Gravel packed Underreamed Open hole Natural Development

Other (describe): \_\_\_\_\_

Top of lap pipe or reduction in casing: N/A feet

*If telescoped or more than one screen, describe on next page*

*Well Only*


County: Coahoma  
 Permit #: BW-47934

For Office Use Only:  
 Well #: C152

The sketch below only required for water wells

If well telescopes, show depths on sketch.

Ground Level →

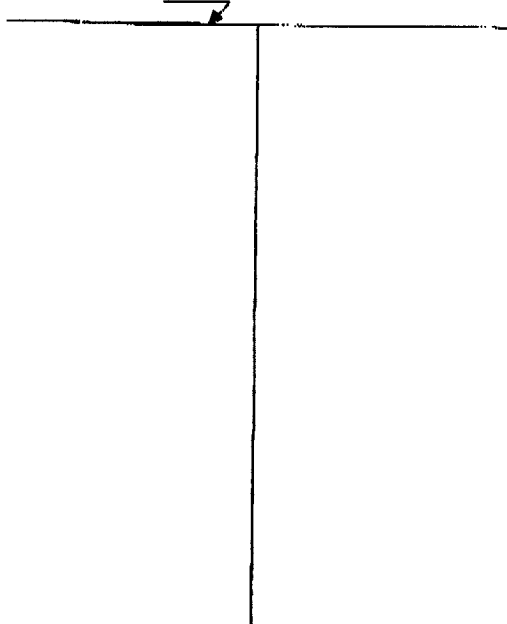


Description of formations encountered must be provided for all wells and boreholes, unless specifically exempted by regulations

Description of Formations Encountered	From (depth)	To (depth)
Clay	Ground level	30
Fine Sand	30	41
Clay	41	48
Medium Sand	48	51
Clay	51	54
Medium Sand	54	58
Medium Coarse Sand	58	70
Clay	70	71
Medium Coarse Sand	71	81
Coarse Sand	81	88
Coarse Sand & Per Gravel	88	90
Coarse Sand & Gravel & Clay	90	93
Coarse Sand & Gravel	93	99
Medium Coarse Sand & Per Gravel	99	107
Medium / Coarse Sand	107	119
Medium / Coarse Sand & Per Gravel	119	125

If more than one screen, show location of each on sketch

Sketch the property layout and include the following:

- 1) the well location
- 2) any permanent structures on the property that may aid in locating the well
- 3) any roads, power lines, or other items that may aid in locating the property and the well
- 4) north arrow

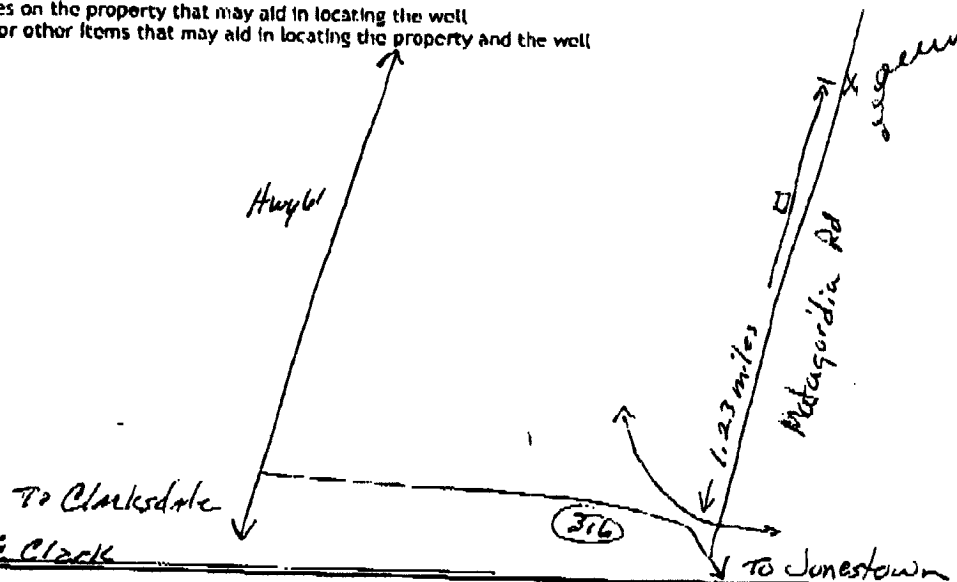

Landowner Name: Cled & Clark

I HEREBY CERTIFY that the well/borehole was drilled, constructed, and completed in accordance with all applicable requirements of the Mississippi Department of Environmental Quality and the Mississippi Department of Health regulations, if applicable, and state laws.

Clayton Miller 0-703 7-10-14 Clayton Miller  
 Print Name of Responsible Licensee and License No. Date Signature of Licensee

# STATE WELL REPORT

## Part 2

### Pump Installer's Completion Report

Mississippi Department of Environmental Quality  
Office of Land and Water Resources  
P.O. Box 2309  
Jackson, MS 39225-2309  
(601)961-5210  
(601) 360-0535 (fax)

**For Office Use Only:**

Well #: \_\_\_\_\_

Aquifer: \_\_\_\_\_

County: COAHOMA  
 Permit #: GW-47934  
 Well: MED-SOUTH WATER  
 Date completed: 6-26-14  
 Copy information from block on Part 1

*This part of the report must be completed by a licensed water well contractor or a licensed pump installer. A copy of Part 1 of the report must be attached and both parts filed with the Department at the above address within 30 days of well completion.*

Well Owner Information	Well Location
Owner Name: <u>ONELA PLANTATION</u>	Latitude: <u>34° 20' 39"</u> Longitude: <u>90° 27' 16"</u>
Mailing Address: <u>P.O. BOX 38</u>	Method of Lat/Long (check one): Conventional Survey _____, USGS quad _____, Hand-held GPS _____, Survey-grade GPS _____
City: <u>TUNICA</u> State: <u>MS</u> Zip Code: <u>38676</u>	<u>SE</u> ¼ <u>NE</u> ¼, Sec <u>310</u> T <u>29N</u> R <u>03W</u>
Telephone No. <u>(662) 363-1121</u>	<u>1/4</u> Miles <u>N</u> of <u>JONESTOWN</u> (Distance) (Direction) (Nearest Town)

**Pump Type (circle one)**

Submersible  Turbine Air Lift Centrifugal Flowing Well Jet Piston Rotary Other (describe): \_\_\_\_\_

Date Pump Installed: 7-22-14 Rated Pump Capacity: \_\_\_\_\_ Gallons Per Minute

Is This Pump (circle one): New Repaired Replacement EXISTING

**Power Type (circle one)**

Electric Diesel Gasoline Natural Gas Tractor PTO Windmill Other (describe): \_\_\_\_\_

Horse Power Rating of Motor: \_\_\_\_\_ Setting Depth: 50 feet Number of Stages: \_\_\_\_\_

**Pump Test Data for Non Flowing Well**

Date Well Tested: \_\_\_\_\_ Duration of Pump Test (minimum 4 hours): \_\_\_\_\_ hours

Static Water Level (A): \_\_\_\_\_ Feet Below Land Surface Pumping Water Level (B): \_\_\_\_\_ Feet Below Land Surface

Drawdown [(B) - (A)]: \_\_\_\_\_ Feet Below Land Surface Test Pumping Rate: \_\_\_\_\_ Gallons Per Minute

Method of measurement (circle one): Steel tape Electric tape Air line Other (describe): \_\_\_\_\_

**Pump Test Data for Flowing Well**

Measured shut in head: \_\_\_\_\_ feet.

Well yielded \_\_\_\_\_ GPM with a drawdown of \_\_\_\_\_ feet after \_\_\_\_\_ hours of pumping

**Meter Installation**

Meter Manufacturer: \_\_\_\_\_ Meter Serial Number: \_\_\_\_\_

Meter Model Number/Name: \_\_\_\_\_ Type of Meter: \_\_\_\_\_

Totalizer Register Unit and Multiplier Factor (AF x .001, gal x 1000, etc): \_\_\_\_\_

Installation Date: \_\_\_\_\_ Meter installed by: \_\_\_\_\_

Is This Meter (circle one): New Repaired Replacement

*Important: By submitting the above information you are certifying that this meter was installed to manufacturer standards. For agricultural wells, a list of approved meters is on the MDEQ website.*

I HEREBY CERTIFY that the above statements are true to the best of my knowledge.

DAVID P. HOLT 0-752P \_\_\_\_\_  
 Print Name of Pump Installer and License No. (if applicable) Date

\_\_\_\_\_  
 Signature of Pump Installer

**RECEIVED**

AUG 20 2014

**OLWR**

14-01