

COAHOMA MISSISSIPPI BOARD OF WATER COMMISSIONERS

D0001

10-12-62

WATER WELL DRILLERS LOG

FIVE COUNTY FARMERS ASS'N

Date: 10/12, 1962, Driller: _____ County: Coahoma

(Name)

| (1) Owner of Land: <u>D. Malvasi</u> (Name) | Description & Color of Materials Sand, Clay, Red Clay, Shell, etc. | Thick- ness Feet | Depth Feet |
|---|---|------------------------|---------------|
| <u>Farrell, Miss</u> (Address) | clay | 50 | 50 |
| (2) Location: _____ 1/4, _____ 1/4, Sec. <u>16 T27R9</u> , | Fine Sand | 4 | 56 |
| <u>1</u> miles <u>SE</u> , of <u>Farrell</u> (distance) (direction) (Nearest Town) | Fine Sand clay | 18 | 74 |
| (3) Topography: _____ (Hilly) (Flat) (Level) | Sand | 4 | 78 |
| (4) Purpose of Well: <u>irrigation</u> (Domestic Irrigation Municipal, Industrial, Other) | Coarse Sand | 15 | 93 |
| | C. Sand Shovel | 21 | 114 |


Information upon completion of well:

- (1) Diameter 12 inches.
- (2) Total Depth 114 feet.
- (3) Water Level 12 feet below top of ground.
- (4) Cased to 78', Size 12".
- (5) Screen: Size 12", Length 36'.
- (6) Were any formations sealed against pollution?
_____ yes, no.

If YES depth of formation _____

Why _____

Drillers Remarks: _____

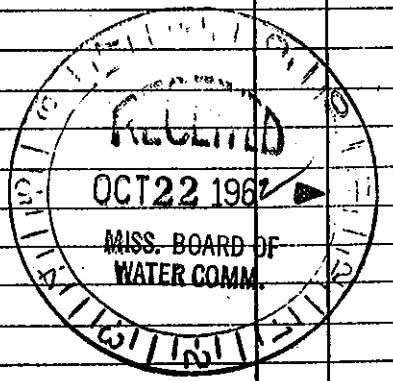

Well No.

(Use Back Side)

Mail this copy to Board of Water Commissioners 429 Miss. St. Jackson, Miss