

COMMON

D 5

5-25-62

WATER WELL DRILLERS

CODED

Date: 5/25, 1962, Driller: FIVE COUNTY FARMERS ASSN. County: Cook
(Name)

(1) Owner of Land:	Description & Color of Materials Sand, Clay, Red Clay, Shell, etc.	Thick- ness Feet	Depth Feet
(Name) <u>John Pelquin</u> <u>Farrell, Miss</u> (Address) <u>30 289</u>	<u>Clay</u> <u>First Sand</u> <u>C. Sand layer</u> <u>ground</u>	<u>12</u> <u>9</u>	<u>12</u> <u>21</u>
(2) Location: <u>1/4</u> , <u>1/4</u> , Sec. <u>13 19 22 25 26 27 28 29</u> <u>W</u> <u>2</u> miles <u>N</u> of <u>Farrell</u> (distance) (direction) (Nearest Town)			
(3) Topography: _____ (Hilly) (Flat) (Level)			
(4) Purpose of Well: <u>irrigation</u> (Domestic irrigation Municipal, Industrial, Other)			

Information upon completion of well:


- (1) Diameter 6 inches.
- (2) Total Depth 88 feet.
- (3) Water Level 15 feet below top of ground.
- (4) Cased to 40, Size 6
- (5) Screen: Size 6, Length 48
- (6) Were any formations sealed against pollution?
 _____ yes, ✓ no.

If YES depth of formation _____

Why _____

Drillers Remarks: _____

CODED

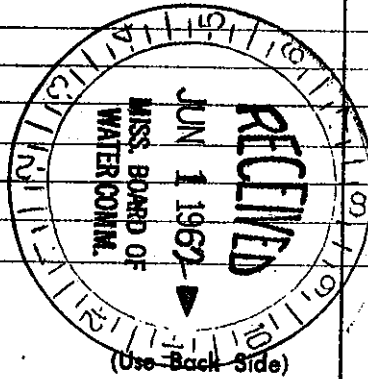

Well No. _____

Mail this copy to Board of Water Commissioners 420 Miss. St. 1st