


D7

12-16-65

WATER WELL DRILLERS LOG

Date: 12-16, 1965, Driller: Five County Farmers Assn Coahoma

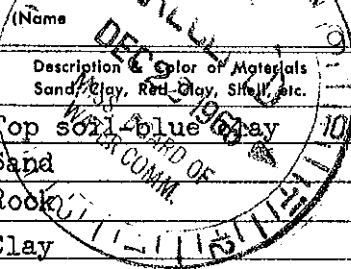

(1) Owner of Land: Carter Stovall
 (Name)
Stovall, Mississippi
 (Address)

(2) Location: 1/4, 1/4, Sec 25 28^N 5^W
1 1/2 miles S. W., of Stovall
 (distance) (direction) (Nearest Town)

(3) Topography: Flat
 (Hilly) (Flat) (Level)

(4) Purpose of Well: Domestic
 (Domestic Irrigation, Municipal, Industrial, Other)

Description Sand, Clay, Red Clay, Shell, etc.	Color of Materials	Thick-ness Feet	Depth Feet
Top soil	blue clay	18	18
Sand		55	73
Rock		6"	73' 6"
Clay		52' 7"	132'
Sand		32'	164'
Clay & shale		152	316
Sand		18' 6"	334' 6"
Rock		6"	335'
Sand		162'	497'
Shale & clay		40'	537'
Sand		263	800'
Wood		5'	805'
Clay, Rock, & Shale		513'	1318'
Sand		21	1339'
Shale & clay streaked with hard rocks		21	1360
Sand		80	1440

Information upon completion of well:

(1) Diameter 2 1/2" - 3" 1/4" inches.

(2) Total Depth 1435' 6" feet.

(3) Water Level 4 1/2' feet below top of ground.

(4) Cased to 147' 7" of 1/4" Size
2' used in swaged nipples 4 x 3
3 x 2 1/2" 12" black on bottom

(5) Screen: Size 2 1/2", Length 30'

(6) Were any formations sealed against pollution?
 yes, no.

If YES depth of formation _____

Why Sanitation

Drillers Remarks: _____

Retain this copy for your office files

(Use Back Side)

Well No.