


D 12

8-6-65

WATER WELL DRILLERS LOG

Date: 8-6, 1965, Driller: Five County Drilling Co. Inc.
 (Name)

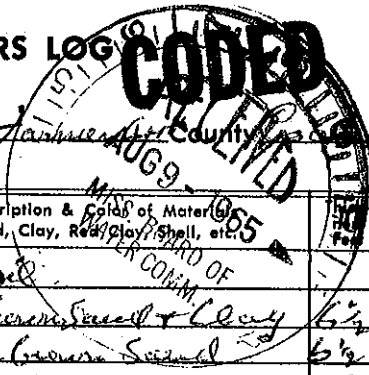

(1) Owner of Land: <u>J.F. HUNTER</u> (Name)	Description & Color of Material Sand, Clay, Red Clay, Shell, etc.	Depth Feet
<u>Furnell Miss</u> (Address) <u>3334 28 5</u>	<u>Topsoil</u>	<u>14 1/2</u>
(2) Location: <u>1/4</u> , <u>1/4</u> , Sec. <u>3, 4, 5, 6, 8</u> T <u>22</u> R <u>5</u>	<u>Fine brown sand & clay</u>	<u>6 1/2</u>
<u>3</u> miles <u>West</u> of <u>Janel</u> (distance) (direction) (Nearest Town)	<u>Fine brown sand</u>	<u>6 1/2</u>
(3) Topography: <u>Flat</u> <u>behind house</u> (Hilly) (Flat) (Level)	<u>Fine grey sand</u>	<u>13</u>
(4) Purpose of Well: <u>irrigation</u> (Domestic, Irrigation, Municipal, Industrial, Other)	<u>medium sand & gravel</u>	<u>19 1/2</u>
	<u>med. sand</u>	<u>6 1/2</u>
	<u>med. sand & lignite</u>	<u>6 1/2</u>
	<u>med. sand</u>	<u>19 1/2</u>
	<u>medium sand & gravel</u>	<u>19 1/2</u>

Information upon completion of well:

- (1) Diameter 6 inches.
- (2) Total Depth 103 feet.
- (3) Water Level 12' feet below top of ground.
- (4) Cased to 55, Size 6
- (5) Screen: Size 6, Length 48
- (6) Were any formations sealed against pollution?
 yes, no.

If YES depth of formation _____

Why _____

Drillers Remarks: _____

Dick & Paul

[Signature]

CODED

(Use Back Side)

Well No.