

COAHOMA MISSISSIPPI BOARD OF WATER COMMISSIONERS

D 13

5-10-65

WATER WELL DRILLERS LOG

**CODED**


Date: 5-10-65, 1965, Driller: FIRE COUNTY TOWN MISS COAHOMA  
(Name)

(1) Owner of Land: <u>CAMEY STOVALL</u> (Name)	Description & Color of Materials Sand, Clay, Red Clay, Shell, etc.	Thick- ness Feet	Depth Feet
<u>WEST END PLTN - STOVALL</u> (Address) <u>MISS</u>	<u>TOPSOIL SANDY</u>		<u>14 1/2</u>
(2) Location: <u>1/4</u> , <u>1/4</u> , Sec. <u>25</u> <u>T28R3</u>	<u>Brushshot - best 2 ft.</u>		
<u>2</u> miles <u>E-W</u> of <u>Stovall</u> (distance) (direction) (Nearest Town)	<u>Brushshot</u>	<u>14 to 34</u>	
(3) Topography: <u>Flat</u> (Hilly) (Flat) (Level)	<u>20' Brushshot</u>		
(4) Purpose of Well: <u>Irrigation</u> (Domestic Irrigation Municipal, Industrial, Other)	<u>Blue mud</u>	<u>6' 40"</u>	
	<u>Sand</u>	<u>13' 53"</u>	
	<u>Very coarse sand</u>		
	<u>with bits of</u>		
	<u>Gravel from 53' to 79'</u>		
	<u>79' Solid Rock -</u>		

Information upon completion of well:

- (1) Diameter 6 inches.
- (2) Total Depth 92' 3" feet.
- (3) Water Level 9' feet below top of ground.
- (4) Cased to 44' 3", Size 6"
- (5) Screen: Size 6", Length 48"
- (6) Were any formations sealed against pollution?  
\_\_\_\_\_ yes,  no.

If YES depth of formation \_\_\_\_\_  
Why \_\_\_\_\_  
Drillers Remarks: \_\_\_\_\_

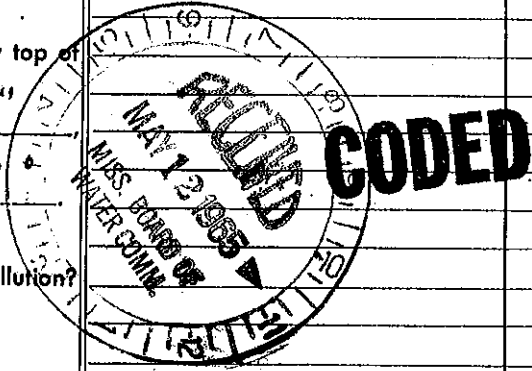

Well No. \_\_\_\_\_

(Use Back Side)

Mail this copy to Board of Water Commissioners 429 Miss. St. Jackson, Miss.