

D 15

11-25-60

WATER WELL DRILLERS LOG

CODED

Date: 11/25, 1960, Driller: Finis County Fines County Cochran
(Name)

(1) Owner of Land:	Description & Color of Materials Sand, Clay, Red Clay, Shell, etc.	Thick- ness Feet	Depth Feet
<u>O. Malovasi</u> (Name) <u>Farrell, Miss</u> (Address)	<u>clay</u>	<u>100</u>	<u>100</u>
(2) Location: <u>1/4</u> , <u>1/4</u> , Sec. <u>36</u> <u>20</u> <u>5</u>	<u>Shovel</u>	<u>34</u>	<u>134</u>
<u>1/2</u> miles <u>SE</u> , of <u>Farrell</u> (distance) (direction) (Nearest Town)			
(3) Topography: <input checked="" type="checkbox"/> (Hilly) <input type="checkbox"/> (Flat) <input type="checkbox"/> (Level)			
(4) Purpose of Well: <u>irrigation</u> (Domestic Irrigation Municipal, Industrial, Other)			

Information upon completion of well:


- (1) Diameter 12 inches.
- (2) Total Depth 134 feet.
- (3) Water Level 25 feet below top of ground.
- (4) Cased to 100, Size 12.
- (5) Screen: Size 10, Length 34.
- (6) Were any formations sealed against pollution?
_____ yes, no.

If YES depth of formation _____

Why _____

Drillers Remarks: _____

CODED

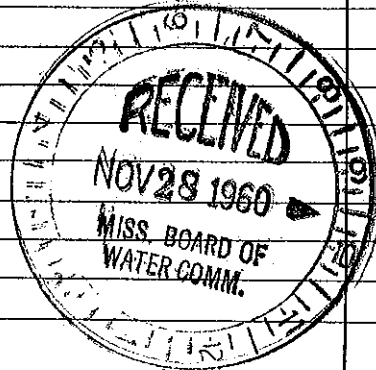

(Use Back Side)

Well No.