

Coahoma  
D19  
4-67

MISSISSIPPI  
BOARD OF WATER COMMISSIONERS  
416 North State Street  
Jackson, Mississippi 39201

**CODED**

WATER WELL DRILLERS LOG

April 21 1967 file county, Farmington Coahoma  
Date well completed firm name county well located


LANDOWNER: <u>R N M WILLIAMS</u>	description of formations encountered	from	to
<u>Jarrell Miss</u>	<u>Top soil + Clay</u>		<u>27</u>
	<u>fine sand</u>	<u>19 1/2</u>	<u>46 1/2</u>
	<u>med sand</u>	<u>32 1/2</u>	<u>88</u>
	<u>Rock, Sand + clay</u>	<u>73 1/2</u>	<u>112</u>

WELL LOCATION:  
sec. 22 T 28 North R. 5 West  
3 1/4 miles NW of Jarrell  
(distance) (direction) (nearest town)

WELL PURPOSE:  
(home, irrigation, municipal, industrial)

- WELL COMPLETION DATA:
- (1) diameter (inches) 6"
  - (2) total depth (feet) 105' 6"
  - (3) static water level (feet) 13' below top of ground.
  - (4) casing Pipe, 57' (depth)  
6" (size) If telescope see back.
  - (5) screen 48', 57' (length) (depth to top)  
6" (size) Open Screen (material)
  - (6) pump 30, 1000 gpm (HP) (yield gpm)
  - (type power)
  - (7) electric log no (yes or no)  
(organization running log)
  - (8) how well bottom plugged

**CODED**

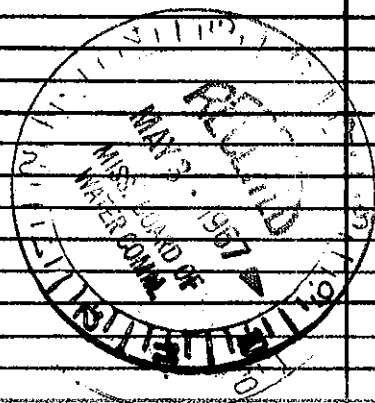

DRILLERS REMARKS: