

Coahoma
D20
8-67

MISSISSIPPI
BOARD OF WATER COMMISSIONERS
416 North State Street
Jackson, Mississippi 39201

CODED

WATER WELL DRILLERS LOG

8-8-67 W. FIVE COUNTY FARMERS ASSN COAHOMA
date well completed firm name county well located

LANDOWNER: DAN CRIMPTON
CLARKSDALE
MISS
(mailing address)

WELL LOCATION:
sec. 33 T. 28 N. R. 5 W.
3 1/4 miles W of Jessell
(distance) (direction) (nearest town)


WELL PURPOSE: IRRI GATION
(home, irrigation, municipal, industrial)

- WELL COMPLETION DATA:
- (1) diameter (inches) 14
 - (2) total depth (feet) 124
 - (3) static water level (feet) 11 below top of ground.
 - (4) casing PIPE, 68 (material) (depth)
 - 14 (size) If telescope see back.
 - (5) screen 48, 68 (length) (depth to top)
 - 14, Case #101 (size) (material)
 - (6) pump 150, 1000 (HP) (yield gpm)
 - 3/4 HP (type power)
 - (7) electric log NO (yes or no)

(organization running log)
(8) how well bottom plugged Welded

DRILLERS REMARKS:

description of formations encountered	from	to
Sandy Topsoil		14
sand		40
med sand		53
Sand + Pea rock		79
Coarse Sand +		
Pea gravel		85 1/2
Sand + gravel		98 1/2
Clay		104
basal. large rocks		115
120 y		124

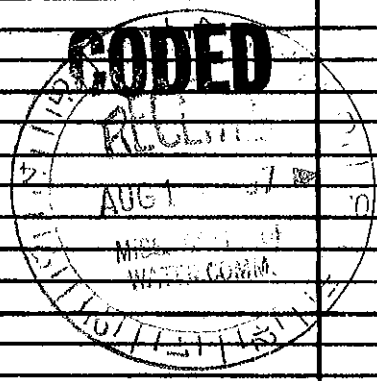

[Handwritten signatures and initials]