County: Coahoma Permit #: GW-45329 45 753 Driller: Irrigation Equipment Date drilling completed: 02/28/2012

State Well Report Part 1 – Driller's Log

Mississippi Department of Environmental Quality
Office of Land and Water Resources
P.O. Box 2309
Jackson, MS 39225
(601) 961-5210

(601) 961-5228 (fax)

Aquifer:	For Office Use Only:	
Well #:		
L.S. Elevatio	n:	
E-log #:		

State Law requires that this report be prepared by the license holder responsible for the work and filed with the Department at the above address within 30 days of completion of drilling of the well or borehole.

			of completion of ariting of the well or borenote.
	nformation on Well O <i>er if borehole is not foi</i>		Well or Borehole Location
Owner NameT	ierra Management Ll	LC	Latitude: 34 ° 18 ' 17 " Longitude: 90 ° 42 ' 22 "
Mailing Address: 3	220 Lakeside Village I	Dr.	Method of Lat/Long (check one): Conventional Survey,
*****			☐ USGS quad, ☐ Hand-held GPS, ☐ Survey-grade GPS
		Ms 86301	SE 1/4 NW 1/4 Sec 15 Twn 28N Rng 5W
C	ity	State Zip code	Distance Direction Nearest Town
Telephone No. () -		3 Miles West of Stovall
		Well / Bo	orehole Data
Date drilling started:	02/28/2012 Date	drilling completed: 02/2	18/2012 Hole depth: 77 Hole diameter: 24"
	e of any surface water used volume of Chlorine used	<u> </u>	
Logs run (check all a Name of organization			Ray Density Sonic Neutron Other:
Purpose of borehole ((check one): Water V	Well Geotechnical	Geological Investigation Ground Source Heat Pump
	☐ Seismic	Survey Other (d	lescribe)
	If drilling is not r	related to water well con	nstruction, skip the remainder of this block
Purpose of Well (chee	ck one)	Industrial Public Sup	ply 🛮 Irrigation 🔲 Fish Culture 🔲 Other:
If flowing, method of	flow regulation: Valve	Other (des	scribe)
Static Water Level:	feet above or	below (check one) 🔲 lan	d □ surface Date measured:
Method of Measurem	ent (check one) 🔲 steel	tape electric tape [air line other:
Well depth: 77	Well grouted to a dep	oth of 10 feet	Type of grout (check one):
Casing length: 57	feet Casin	ng diameter: 16	inches Type of casing: PVC
Screen length: 20	feet Scree	n diameter: 16	inches Type of screen: PVC
Screen slot size:	50 inches	Setting depth: From	<u>58</u> feet to <u>77</u> feet
Type of completion (c	check all applicable):	Gravel packed U	nderreamed Telescoped Open hole Natural Development
	Þ	Other (describe): Cir	cle S Irrigation will set pump
Top of lap pipe or red	uction in casing:	feet. If	telescoped or more than one screen, describe on next page

Form: OLWR-SWR-1A (04/08)

RECEIVED

MAR 0 5 2012

BY: OLWR

If well telescopes, show depths on sketch.

<u>Descri</u>	ptio
	_

on of formations encountered must be provided for all wells and boreholes, unless specifically exempted by regulations

Ground level	Description of Formations Encountered	From (depth)	To (depth)
	Clay	Ground level	39
	Fine Sand & Clay	40	49
	Fine Sand & Gravel	50	54
	Medium Sand & Gravel	55	75
	Clay	76	77
	Al III		
			-
		 	-
		····	
		 	
		†	
		<u> </u>	
		 	
1		<u> </u>	L
If more than one screen, show location of each on sketch	•		
Sketch the property layout and include the following: 1) the well	location; 2) any permanent structures on the	property that	may
aid in locating the well; 3) any roads, power lines	, or other items that may aid in locating the p	property and the	ne well;
4) a north arrow.			ŕ

Landowner Name:

Tierra Management LLC

Form: OLWR-SWR-1A (04/08)

I certify that the well/borehole was drilled, constructed, and completed in accordance with all applicable requirements of the Mississippi Department of Environmental Quality and the Mississippi Department of Health regulations, if applicable, and state

Patrick Chism/Irrigation Equipment 0695

Print Name of Responsible Licensee and License No.

03/01/2012

Signature of Licensee

RECEIVED

MAR 0 5 2012

BY: OLWR

Form provided by Forms On-A-Disk · 214-340-9429 · FormsOnADisk.com

CDAHOMA

Date completed: 2.28-12

Copy information from block on Part 1

STATE WELL REPORT

Part 2

Pump Installer's Completion Report Mississippi Department of Environmental Quality Office of Land and Water Resources

P.O. Box 2309 Jackson, MS 39225 (601)961-5210 (601)961-5228 (fax)

For Office Use Only:	
Aquifer: 58	_
Well #:	_
Elevation:	-

This part of the report must be completed by a licensed water well contractor or a licensed pump installer. A copy of Part 1 of the

report must be attached and both parts filed with the Department at the above address within 30 days of well completion.			
Well Owner Information	Well Location		
Owner Name: TERRA MANAGEMENT	Latitude: 340181/7.69" Longitude: 90042, 20.34"		
Mailing Address: 2921-B 5. KISH AVE	Method of Lat/Long (check one): Conventional Survey,		
Telephone No. (928) 342 - 7300	USGS quad, Hand-held GPS, Survey-grade GPS		

	Pump Typ Circle one			Power Type Circle one	
Air Lift	Jet	Submersible	Diesel Engine	Gasoline Engine	Natural Gas
Bucket	Piston	Turbine	Electric Motor	Hand	Tractor PTO
Centrifugal	Rotary	Flowing Well	Windmill	Other (specify):	
Other (specify):			Horse Power Ratin	g of Motor: 40)
Date Pump Installed:	Ž	4.5-12	Setting Depth:	60	feet
Rated Pump Capacity:	1600	Gallons Per Minute	Number of Stages:	2	

Pump Test Data		Method of Measuring Water Level Circle one		
Date Well Tested:			Chele one	
Static Water Level (A):	Feet Below Land Surface	Air Line	Electric Measuring Line	Steel Tape
Pumping Water Level (B):	Feet Below Land Surface	Other (specif	ÿ):	
Drawdown [(B) – (A)]:	Feet Below Land Surface	For flowing v	well, measured shut in head:	feet
Test Pumping Rate:		Well yielded	GPM with	a drawdown of
Duration of Pump Test (minimum	m 4 hours):hours		feet after	hours of pumping


I HEREBY CERTIFY that the above statements are true to the best of my knowledge.

HOLT Print Name of Pump Installer and License No. (if applicable)

Signature of Pump Installer

RECEIVED

Form: OLWR-SWR-1B (04/08) 3 2012

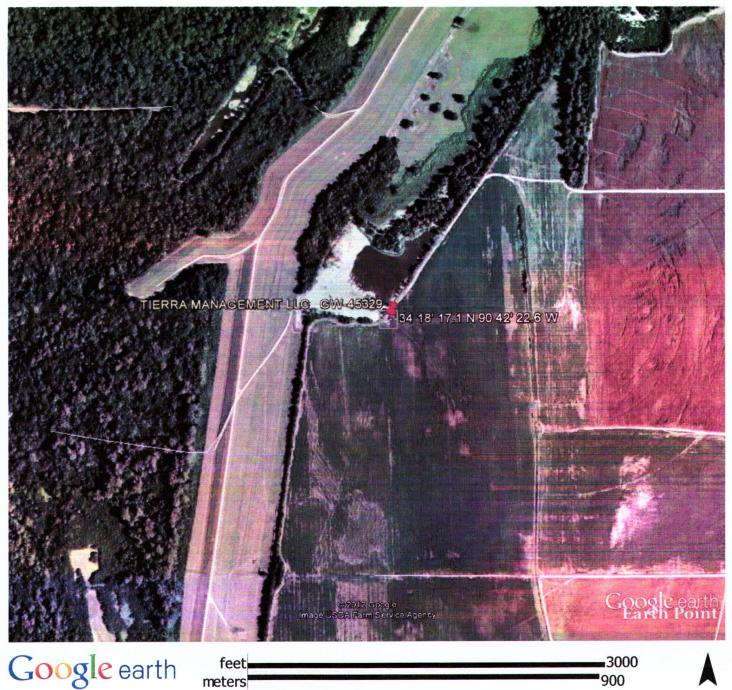

Google earth

feet meters

RECEIVED

MAR 0 5 2012

BY: OLWR