County:	Coahoma	
Permit #:	GW-46574 J	
Driller:	Irrigation Equipme	nt
Date drilli	ing completed: 08/14/20	12

Ť.

State Well Report Part 1 – Driller's Log Mississippi Department of Environmental Quality Office of Land and Water Resources P.O. Box 2309 Jackson, MS 39225 (601) 961-5210 (601) 961-5228 (fax)

For Office Use Only:				
Aquiter: D63				
Well #:				
L.S. Elevation:				
E-log #:				

In:L

State Law requires that this report be prepared by the license holder responsible for the work and filed with the Department at the above address within 30 days of completion of drilling of the well or borehole.

Information on Well Owner	Well or Borehole Location
(Landowner if borehole is not for a water well)	
Owner Name Riverbend Farms	Latitude: <u>34</u> ° <u>15</u> ' <u>10</u> " Longitude: <u>90</u> ° <u>44</u> ' <u>33</u> "
Mailing Address: P.O. Box 897	Method of Lat/Long (check one):
	🔲 USGS quad, 🛛 Hand-held GPS, 🗌 Survey-grade GPS
Clarksdale Ms 38614	SW 1/4 SW 1/4 Sec 32 Twn 28N Rng 5W
City State Zip code	Direction Nearest Town
Telephone No.        (        )        -	9 Miles Northwest of Clarksdale
Well / Bo	rehole Data
Date drilling started: 08/14/2012 Date drilling completed: 08/14	Hole depth: 125 Hole diameter: 24"
Location of the source of any surface water used for drilling: Surface	Water
Method of dosing and volume of Chlorine used in drilling and development	
Logs run (check all applicable): 🛛 No log run 🗌 Electric 🔲 Gamma I Name of organization running log(s):	
Purpose of borehole (check one): Water Well Geotechnical/	
Seismic Survey Other (da If drilling is not related to water well con	scribe)
Purpose of Well (check one)  Home  Industrial  Public Supp	
If flowing, method of flow regulation: Valve Other (desc	
Static Water Level: feet above or below (check one) 🗌 land	
Method of Measurement (check one) 🗆 steel tape 🖾 electric tape	
Well depth: <u>125</u> Well grouted to a depth of <u>10</u> feet	Type of grout (check one): 🗌 Neat Cement 🛛 Bentonite 🗌 Mix
Casing length: 85 feet Casing diameter: 16	inches Type of casing: <b>PVC</b>
Screen length: 40 feet Screen diameter: 16	inches Type of screen: <b>PVC</b>
Screen slot size: .050 inches Setting depth: From	86 feet to 125 feet
Type of completion (check all applicable): X Gravel packed U	nderreamed 🔲 Telescoped 📄 Open hole 🗌 Natural Development
Other (describe): Cir	cle S Irrigation will set pump
Top of lap pipe or reduction in casing: feet. If	telescoped or more than one screen, describe on next page
Top of lap pipe or reduction in casing: feet. If	<u>telescoped or more than one screen, describe on next page</u> Form: OLWR-SWR-1A (04/08)

## The sketch below only required for water wells

If well telescopes, show depths on sketch.

Ground level

ł

.


Description of formations encountered must be provided for all wells and boreholes, unless specifically exempted by regulations

Description of Formations Encountered	From (depth)	To (depth)
Clay	Ground level	18
Fine Sand	19	59
Fine Sand & Gravel	60	67
Medium Sand & Gravel	68	125
· · · · · · · · · · · · · · · · · · ·		
		T
an and the second s		
		r
		†
		ł

If more than one screen, show location of each on sketch

Sketch the property layo aid in lo 4) a nort	cating the well; 3) any roa	ing: 1) the well location ads, power lines, or othe	n; 2) any permanent structures r items that may aid in locating	on the property that may g the property and the well;
Landowner Name:	Riverbend Farms			
l certify that the well/bore Mississippi Department of	hole was drilled, construct Environmental Quality ar	ed, and completed in acc nd the Mississippi Depart	ordance with all applicable requirement of Health regulations, if a	Form: OLWR-SWR-1A (04/08) irements of the pplicable, and state
aws. Patrick Chism 069	5	09/14/2012	Jan	
Print Name of Responsible Licens	ee and License No.	Date	Signature of Licensee	SEP in care
				ter han a star and a star and a star a st
		- ARist		

STATE WI	ELL REPORT
County: <u>('DAHOWNA</u> Permit #: <u>GW - 46574</u> Driller: <u>TREIGATION EQUERMUT</u> Date drilling completed: <u>8-14-17</u> Conv information from block on Part I	art 2      For Office Use Only:        Completion Report      Aquifer:        t of Environmental Quality      Well #:        md Water Resources      Elevation:        Box 2309      MS 39225        961-5210      1-5228 (fax)
This part of the report must be completed by a licensed water we report must be attached and both parts filed with the Department	ell contractor or a licensed pump installer. A copy of Part 1 of the nt at the above address within 30 days of well completion.
Well Owner Information	Well Location
Owner Name: <u><b>RIVERBEND</b></u> FARMS	Latitude: 34. 15. 10. 26. Longitude: 90. 44. 32. 58.
Mailing Address: <b>P.O. BOx 897</b>	Method of Lat/Long (check one): Conventional Survey,
	🗌 USGS quad, 🔲 Hand-held GPS, 🔲 Survey-grade GPS
<u>CLAPESOALS</u> MS <u>3864</u> City State Zip code	<u>Sw</u> <sup>1</sup> / <sub>4</sub> <u>Sw</u> <sup>1</sup> / <sub>4</sub> Sec <u>32</u> T <u>28</u> <sup>1</sup> / <sub>2</sub> R <u>5w</u> Distance Direction Nearest Town <u>3<sup>1</sup>/<sub>2</sub></u> Miles <u>NNW</u> of <u>StARAD</u>
Pump Type	Power Type
Check one	Check one
Air Lift Det Submersible	Diesel Engine Gasoline Engine Natural Gas   Electric Motor Hand Tractor PTO
Centrifugal Rotary Flowing Well	L Electric Motor    Hand    Tractor PTO      Windmill    Other (specify):
Other (specify):	Horse Power Rating of Motor:
Date Pump Installed: 8-20-12	Setting Depth: 70 feet
ated Pump Capacity //OO Gallons Per Minute	Number of Stages: <u>5</u>
Pump Test Data	Method of Measuring Water Level Check one
ate Well Tested:	Air Line Electric Measuring Line Steel Tape
atic Water Level (A): Feet Below Land Surface	Other (specify):
umping Water Level (B): Feet Below Land Surface	
rawdown [(B) - (A)]: Feet Below Land Surface	For flowing well, measured shut in head: feet
est Pumping Rate: Gallons Per Minute	Well yielded GPM with a drawdown of
uration of Pump Test (minimum 4 hours): hours	feet after hours of pumping
This is for (check one): New Well Replacen	nent of Existing Pump
HEREBY CERTIFY that the above statements are true to the best of m <u>DANED P. HOLT</u> <u>O-752 P</u> Print Name of Pump Installer and License No. (if applicable)	iy knowledge. Signature of Pump Installor Form: OKORSSWR&I Clot 191

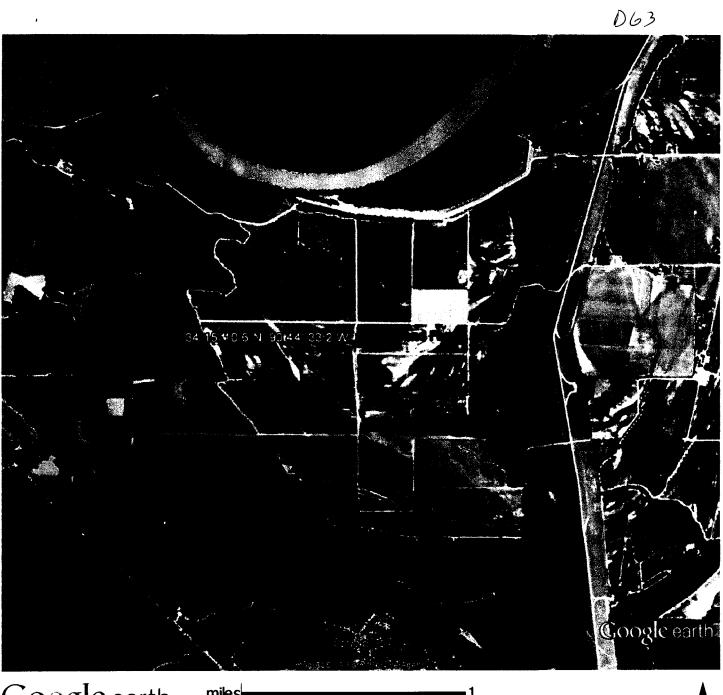

Google earth miles \_\_\_\_\_1

SEP 1