

COAHOMA MISSISSIPPI BOARD OF WATER COMMISSIONERS

E 0002

7-24-65

WATER WELL DRILLERS LOG

Date: July 24, 1965, Driller: Jude County James County Coahoma
(Name)

(1) Owner of Land: <u>O Malavasi</u> <small>(Name)</small>	Description & Color of Materials Sand, Clay, Red Clay, Shell, etc.	Thick- ness Feet	Depth Feet
<u>Clarksdale Miss</u> <small>(Address)</small>	<u>Gumbo</u>		<u>27 1/2</u>
(2) Location: <u>1/4, 1/4, Sec. T R</u>	<u>Soft blue clay</u>	<u>32 1/2</u>	<u>60</u>
<u>2 miles N of Sam</u> , of <u>Samuel</u> <small>(distance) (direction) (Nearest Town)</small>	<u>Med. Gray Sand</u>	<u>13</u>	<u>73</u>
(3) Topography: <u>Flat</u> <small>(Hilly) (Flat) (Level)</small>	<u>Medium Sand & gravel</u>	<u>45 1/2</u>	<u>118 1/2</u>
(4) Purpose of Well: <u>Irrigation</u> <small>(Domestic Irrigation Municipal, Industrial, Other)</small>	<u>" " "</u>	<u>1 1/2</u>	<u>120</u>
	<u>Batter out in</u>		
	<u>Blue Clay</u>		


Information upon completion of well:

- (1) Diameter 14 inches.
- (2) Total Depth 120 feet.
- (3) Water Level 13' 6" feet below top of ground.
- (4) Cased to 69', Size 14
- (5) Screen: Size 14, Length 48'
- (6) Were any formations sealed against pollution?
 yes, no.

If YES depth of formation _____

Why _____

Drillers Remarks: [Signature]

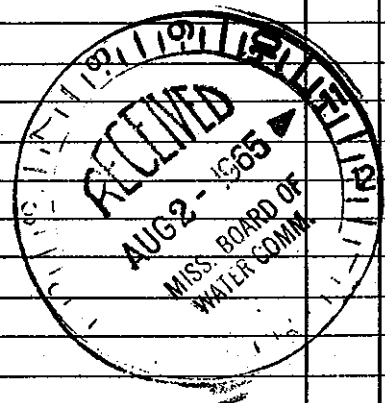

(Use Back Side)

Well No.

Mail this copy to Board of Water Commissioners 429 Miss. St. Jackson, Miss.