

COAHOMA MISSISSIPPI BOARD OF WATER COMMISSIONERS

E 15

9-21-65

WATER WELL DRILLERS LOG


**CODED**

Coahoma

Date: Sept 21, 1965, Driller: Delta Drilling Co County Coahoma

(Name)

	Description & Color of Materials Sand, Clay, Red Clay, Shell, etc.	Thick- ness Feet	Depth Feet
(1) Owner of Land: <u>W. C. Mc Caughan</u> (Name) <u>Clarksdale, Miss.</u> (Address)	Top soil + sand	83	83
	gravel	44	127
	gumbo	41	168
(2) Location: <u>NE 1/4, NW 1/4, Sec. 32 T28N R4E</u>  _____ miles _____ of _____ (distance) (direction) (Nearest Town)	gravel	20	188
	shale	52	240
	Sand	18	258
(3) Topography: _____ (Hilly) (Flat) (Level)	gumbo	72	330
	Sand	64	394
(4) Purpose of Well: <u>MUNICIPAL</u> (Domestic Irrigation Municipal, Industrial, Other)	Shale	45	439
	Sand	96	535
	Shale	41	576
Information upon completion of well:	gumbo	40	616
(1) Diameter <u>4</u> inches.	Shale <b>CODED</b>	22	638
(2) Total Depth <u>1171</u> feet.	SAND	34	672
(3) Water Level <u>FLOWS</u> feet below top of ground.	Shale	21	693
(4) Cased to <u>1171</u> , Size <u>696'-4" 475'-2 1/2"</u>	Sand	94	787
(5) Screen: Size <u>2.0</u> , Length <u>2"</u>	Shale	18	805
(6) Were any formations sealed against pollution? _____ yes, _____ no.	green sand	10	815
If YES depth of formation _____	Shale w/ Rock	28	843
Why _____	Gumbo	59	902
Drillers Remarks: <u>2.0' Lap or 2 1/2"</u>	Shale	20	922
<u>in 4" pipe</u>	Sand w/ 5" Rock	8	930
	Shale	11	941
	Brown Sand	22	963
	Shale	33	996
	sand	18	1014
	Shale	26	1040
	White sand	40	1080
	gumbo	19	1099
	Shale	14	1113
	White Sand	34	1147
	gumbo	24	1171

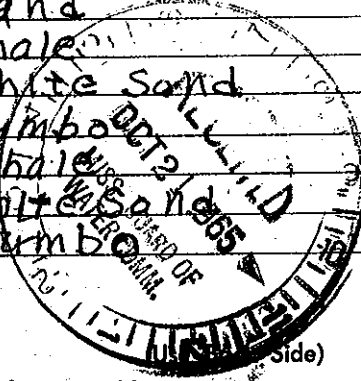

Mail this copy to Board of Water Commissioners 429 Miss. St. Jackson, Miss.