

COAHOMA MISSISSIPPI BOARD OF WATER COMMISSIONERS


E 20

9-3-65

WATER WELL DRILLERS LOG

**CODED**

Date: Sept 3 1965, Driller: FIVE COUNTY FURNACE County CLAY  
(Name)

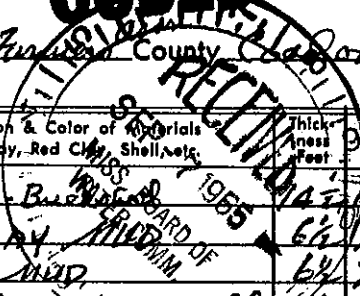

(1) Owner of Land: Waterloo Inc.  
W.H. Stovall (Name)  
STOVALL MISS (Address)

(2) Location: 1/4 1/4, Sec. 29 T8R4,  
1/2 miles East of Stovall  
(distance) (direction) (Nearest Town)

(3) Topography: flat  
(Hilly) (Flat) (Level)

(4) Purpose of Well: Irrigation  
(Domestic, Irrigation, Municipal, Industrial, Other)

Description & Color of Materials Sand, Clay, Red Clay, Shell, etc.	Thickness Feet	Depth Feet
Top Soil - Buckshot	1 1/2	1 1/2
CLAY - MUD	6 1/2	21
Soft MUD	6 1/2	27 1/2
Soft Brown MUD Clay	6 1/2	34
MUD	6 1/2	40 1/2
Blue MUD	6 1/2	47
" "	6 1/2	53 1/2
" "	6 1/2	60
FINE SAND - BIG LOG -	6 1/2	66 1/2
Fine Sand - lignite	6 1/2	73
Fine Sand, lignite + wood	19 1/2	92 1/2
MED. SAND small gravel	6 1/2	99
Sand - larger small gravel	39	138

Information upon completion of well:

(1) Diameter 14 inches.

(2) Total Depth 138 feet.

(3) Water Level 18' 4" feet below top of ground.

(4) Cased to 90, Size 14"

(5) Screen: Size 14", Length 48"

(6) Were any formations sealed against pollution?  
\_\_\_\_\_ yes, \_\_\_\_\_ no.

If YES depth of formation \_\_\_\_\_

Why \_\_\_\_\_

Drillers Remarks: [Signature]

**CODED**

(Use Back Side)

Well No.

Mail this copy to Board of Water Commissioners 429 Miss. St. Jackson, Miss.