	State W	ell Report			
County: Coghoma	Part 1 – Driller's Log		For Office Use Only:		
	Mississippi Department of Environmental Quality		Aquifer: E 150		
Permit#: <u>GW43613</u> Trrigation Egginment		nd Water Resources	Well #:		
Irrigation Equipment	P.O. Box 2309 Jackson, MS 39225				
Date drilling completed: 11-11-09	• •	961- 5210	L. S. Elevation:		
	(601)96	1- 5228 (fax)	E-log #:		
State Law requires that this report be prepared by the license holder responsible for the work and filed with the					
Department at the above address within 30 days of completion of drilling of the well or borehole.					
Information on Well Owner Well or Borehole Location (Landowner if borehole is not for a water well)					
		Latitude: H . 8,	" Longitude 10 · 46 31 "		
Owner Name Tim Morris	rarms	1	,		
Mailing Address: 6135 Friars Point Rd.		Method of Lat/Long (circle one): Conventional Survey, USGS quad, Hand-held GPS, Survey-grade GPS			
Clarksdale Ms. 38614 City State Zip Code		NE 1/2 Sec 16 Twn 28N Rng 4W			
	_	Distance Direction Nearest Town Miles SE of Frigers Point			
Telephone No. (662) 902 - 93	Telephone No. 662 902 - 9205 — — Miles SE of Frigres Moin /		N 171415 [WINT		
	Well / Bore	hole Data			
Date drilling started: 11-11-09 Date drilling completed: 11-11-09 Hole depth: 118 Hole diameter: 24"					
I will a control of the control of t					
Method of dosing and volume of Chlorine	used in drilling and devel	opment: 50 ppm			
Logs run (circle all applicable): lo log run Electric Gamma Ray Density Sonic Neutron Other: Name of organization running log(s):					
Purpose of borehole (check one): Water Well X Geotechnical/Geological Investigation Ground Source Heat Pump					
Seismic Survey Other (describe)					
Scisific Survey Other (aescribe) If drilling is not related to water well construction, skip the remainder of this block					
Purpose of Well (check one): Home Industrial Public Supply Irrigation Fish Culture Other:					
If a flowing well, method of flow regulation: Valve Other (describe)					
Static Water Level: 15 feet above of below (circle one) land surface Date measured: 11-13-09					
Method of Measurement (circle one) steel tape electric tape air line other:					
Well depth: 118 Well grouted to a depth of 10 feet Type of grout (circle one): Neat Cement Bentonite Mix					
Casing length: 79 feet Casing diameter: 16 inches Type of casing: PVC					
Screen length: 39 feet Screen diameter: 16 inches Type of screen: PVC					
Screen slot size:					
Type of completion (circle all applicable): Cravel packed Underreamed Telescoped Open hole Natural Development					
Other (describe):					
Top of lap pipe or reduction in casing:feet. If telescoped or more than one screen, describe on next page					

Form: OLWR-SWR-1A (04/08)



NOV 2 8 200s

BY: OLWR

		1.15	\mathcal{O}
he sketch below only required for water wells	Description of formations encountered	must be provided	for all
fuell telegooner about deaths on shetch	wells and boreholes, unless specificall	y exempted by regi	<u>ulations</u>
f well telescopes, show depths on sketch. Ground Level	Description of Formations Encountered	From (depth)	To (depth)
Ground Edvor	Clay	Ground Level	1 36
	Fine Sand & Clay	27	50
}	Clay	51	70
	Fint Sand	71	76
Ì	Medium Sand & Grave	1 77	115
	Fine Sand	116	118-
	· · · · · · · · · · · · · · · · · · ·	- -	
		 	
			
			+
j			
			1
		<u> </u>	
			<u> </u>
			
		 	
4) a north arrow.	nes, or other items that may aid in locating the pr	operty and are wer	',
			i
			ŀ
downer Name: Tim Morris Fo	3 1014		
idowner Name: 1777 1770//13 10	<u>irms</u>		
	T	·· OI Um cum ·	A (04/00)
		a: OLWR-SWR-17	` ,
tify that the well/borehole was drilled, constructed, an			
issippi Department of Environmental Quality and the	Mississippi Department of Health regulations	if applicable, an	d state
	1 0 1	()	
John P. Chism 0439	1 0/1 11)/	X	

Date

Print Name of Responsible Licensee and License No.

RECEIVED

NOV 2 8 2009

BY: OLWR

STATE WELL REPORT

County: <u>Coahoma</u> Permit #: Irrigation Equipment Driller: Date completed: 11-11-09

Part 2
Pump Installer's Completion Report
Mississippi Department of Environmental Quality
Office of Land and Water Resources
P.O. Box 2309

P.O. Box 2309 Jackson, MS 39225 (601)961-5210 (601)961-5228 (fax)

For Office Use Only:				
Aquifer:	EISO			
Well #: _				
Elevation				

(601)961-5228 (fax) Copy information from block on Part 1 This part of the report must be completed by a licensed water well contractor or a licensed pump installer. A copy of Part 1 of the report must be attached and both parts filed with the Department at the above address within 30 days of well completion. Well Owner Information Well Location Latitude: Method of Lat/Long (check one): Conventional Survey____, USGS quad , Hand-held GPS , Survey-grade GPS Clarksdale Ms. 38614
City State Zip Code NE 4 NE 4 Sec 16 T 28NR 4W Distance Direction Telephone No. (662) 902 - 9205 4 Miles SE of Friars **Pump Type Power Type** Circle one Circle one Air Lift Jet Submersible Diesel Engine Gasoline Engine Natural Gas **Bucket** Piston Turbine) **Electric Motor** Hand Tractor PTO Centrifugal Rotary Flowing Well Windmill Other (specify): Other (specify): Horse Power Rating of Motor: 60 Setting Depth: Rated Pump Capacity: Number of Stages: Pump Test Data Method of Measuring Water Level Circle one Date Well Tested: ___ Air Line **Electric Measuring Line** Steel Tape Static Water Level (A): Feet Below Land Surface Other (specify): Pumping Water Level (B): _____Feet Below Land Surface Drawdown [(B) - (A)]: _____Feet Below Land Surface For flowing well, measured shut in head: feet Test Pumping Rate: Gallons Per Minute Well yielded GPM with a drawdown of


I HEREBY CERTIFY that the above statements are true to the best of the statements are true to the statement are true true to t	my knowledge.
John P. Chism 0439	Jah 175
Print Name of Pump Installer and License No. (if applicable)	Signature of Pump Installer

Duration of Pump Test (minimum 4 hours): hours

Form: OLWR-SWR-1B (04/08)

_____feet after _____hours of pumping

NOV 2 9 2009

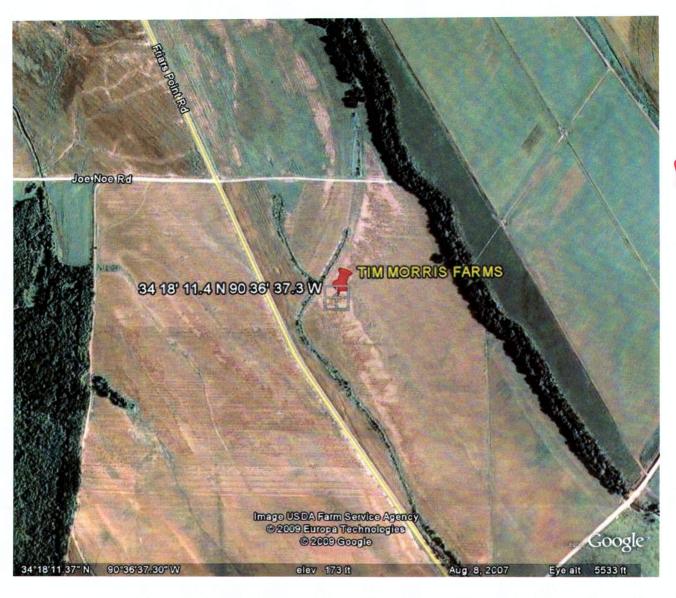

EISO

RECEIVED NOV 2 0 2009 BY: OLWR