
State V	Vell Report	For Office Use Only:
County: Coahoma Part 1-	Driller's Log	
	nt of Environmental Quality and Water Resources	Nell#: ELOT
P.O.	Box 2309	Well #:
(000)	n, MS 39225 1961- 5210	L. S. Elevation:
	1- 5228 (fax)	E-log #:
State Law requires that this report be prepared by the lie	ense holder responsible for i	
State Law requires that this report be prepared by the id- Department at the above address within 30 days of com	menon of utumes of the sex	0.00.000
Information on Well Owner	77 C41 U3 100	i endre more
(Landowner if borehole is not for a water well)	Latitude: 34 ° 19 '51	" Longitude: 90 ° 35 ° 7 "
Owner Name Tim Mouns	Method of Lat/Long (circle or	ne): Conventional Survey,
Mailing Address: 6135 Friars Point	USGS quad, Hand-held	GPS, Survey-grade GPS
Kd. 2011	SW 1/4 NW/4 Sec_ 03	L Twn 28N Rng 04W
City State Zip Code	Distance Direction A Miles SW	of Ruch Your
Telephone No. ()		
Well / Bor		
Date drilling started: 3-25-16 Date drilling completed: 3-25-16 Hole depth: 115 Hole diameter: 2810		
Location of the source of any surface water used for drilling:		
Logs run (circle all applicable): Ne log run Electric Gamma Ray Density Sonic Neutron Other: Name of organization running log(s):		
Purpose of borehole (check one): Water Well Geotechnical/Geo	logical Investigation Ground	Source Heat Pump
Other (describe)		
If drilling is not related to water well construction	on, skip the remainaer of this or	/LK
Purpose of Well (check one): Home Industrial Public Suppl	y Irrigation Fish Culture	Other:
If a flowing well, method of flow regulation: Valve Other (describe)		
Static Water Level:		
Method of Measurement (circle one) steel tape electric tape air line other:		
Well depth: 15 Well grouted to a depth of 15 feet Type of grout (circle one): Neat Cement (Bentonite) Mix		
Casing length: 75 feet Casing diameter: 16 inches Type of casing: 900		
Screen length: 40 feet Screen diameter: 16 inches Type of screen: 40 c		
Screen slot size: O. T inches Setting depth: From		feet hole Natural Development
Type of completion (circle all applicable): Cravet packet		
Other (describe):		
Top of lap pipe or reduction in casing:feet. If te	lescoped or more than one scre	en, describe on next page

Form: OLWR-SWR-1A (04/08)

Received

APR 2 2 2016

The sketch below only required for water wells

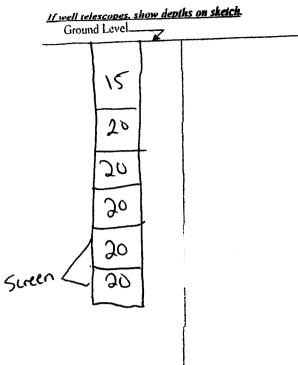

Description of formations encountered must be provided for all wells and boreholes, unless specifically exempted by regulations

	_	
Description of Formations Encountered	From (depth)	To (depth)
	Ground Level	40
	30	10P
Fine Sough	CIN	(00)
Sanch	10	+ 22
Course space	l CO	1 00
Constant Mark	X 80_	100
Course south grave	100	115
graves		
	 	1
	<u></u>	
	+	
	 	
	1	
	 	
	+	1
		
	 	

If more than one screen, show location of each on sketch

If more than one screen, show location	
the same and the	property that may
Sketch the property layout and include the following: 1) the well location; 2) any permanent structures of the aid in locating the well 3) any mads, power lines or other items that may aid in locating the property layout and include the following: 1) the well location; 2) any permanent structures of the	boerty and the well:
Sketch the property layout and in locating the property layout and layout layout and layout)
	1
4) a north arrow.	1 ,\
4) a north arrow. well	1 6
	h .
	1 4
M Fram	1 Kuit
Farm	(0)
(Stot)	l i
· • • • • • • • • • • • • • • • • • • •	1
1	1
1 xui	
	1 1
King &	[
	1
Andrson	1
	1
	1
	1
\ \ \ \ \ \ \ \ \ \ \ \ \ \ \ \ \ \ \	1
\ \ \\ \\ \\ \\ \\ \\ \\ \\ \\ \\ \\ \\	i i
clanksdale	1 1
- Marking	\ i
4 5.5	1
\ \ \ \ \ \ \ \ \ \ \ \ \ \ \ \ \ \ \	1
	1
	1
	1
	1
	[
	1
Time Morris]
	1
For	m: OI.WR-SWR-1A (04/08)
	a requirements of the

Landowner Name: 11111		Form: OLW	R-SWR-1A (04/08)
I certify that the well/borchole was di	rilled, constructed, and completed	i in accordance with all applicable require Department of Health regulations, if app	rements of the plicable, and state Received
iaws.	7-751	. and som	Deceived
Print Name of Responsible Licensee	and License No. Date	Signature of Licensee	APR 2 2 2016
Print Name of Responsible Licensee	apa Enterior		- 0114M

STATE WELL REPORT

County: _Conhomos Permit #: _GW- 49203 Driller: __Joel Jumper Date completed: _3-25-16 Copy information from block on Part 1

Part 2

Pump Installer's Completion Report Mississippi Department of Environmental Quality Office of Land and Water Resources

P.O. Box 2309 Jackson, MS 39225-2309 (601)961-5210 (601) 360-0535 (fax)

For (Office Use Only:
Well #:	E167
Aquifer:	

This part of the report must be completed by a licensed water of the report must be attached and both parts filed with the L	r well contractor or a licensed pump installer. A copy of Part 1 Department at the above address within 30 days of well completion.
Well Owner Information	· Well Location
Owner Name: Tim Morris	Latitude: 34-19-51 Longitude: 90-35-7
Mailing Address: Co135 Frians Point	Method of Lat/Long (check one): Conventional Survey,
Rd	USGS quad, Hand-held GPS, Survey-grade GPS
Clarksdale Us 38614	SW 14 NW 14, Sec D2 T 28 NR 04W
City State Zip Code	2 Miles 5W of Rudyard
Telephone No. ()	(Distance) (Direction) (Nearest Town)
Pump Typ	pe (circle one)
Submersible Turbine Air Lift Centrifugal Flowing Well	Jet Piston Rotary Other (describe):
Date Pump Installed: 3-25-16 R	Rated Pump Capacity:
Is This Pump (circle one): New Repaired Replacemen	nt
Power Typ	pe (circle one)
	dmill Other (describe):
Horse Power Rating of Motor: (O) H Setting Depth	h: 50 feet Number of Stages: 2
Pump Test Data f	for Non Flowing Well
Date Well Tested: 3-25-16	Duration of Pump Test (<i>minimum 4 hours</i>): hours
Static Water Level (A): 15 Feet Below Land Surface	Pumping Water Level (B): 30 Feet Below Land Surface
	ace Test Pumping Rate: 2200 Gallons Per Minute
	De Air line Other (describe):
	a for Flowing Well
Measured shut in head:feet.	
Well yieldedGPM with a drawdown of	feet after hours of pumping
	estallation
Meter Manufacturer:	
	Type of Meter:
Totalizer Register Unit and Multiplier Factor (AF x .001, gal x	•
	1000, etc)
Installation Date: Meter installed by:	
Is This Meter (circle one): New Repaired Replacement	
Important: By submitting the above information you are cert For agricultural wells, a list of appro	ifying that this meter was installed to manufacturer standards. oved meters is on the MDEQ website.
HEREBY CERTIFY that the above statements are true to the	Dassiy
inches central dide die above statements are tibe to the i	
Joel Jumper 5311	3-25-16 (sal)- APR 222
ring Name of Pump Installer and License No. (if applicable)	Date Signature of Pughp Installer 11 12 13 14 14 14 15 15 15 15 15

By OLWR