

COAHOMA MISSISSIPPI BOARD OF WATER COMMISSIONERS

F0002

6-5-65

WATER WELL DRILLERS LOG

Date: 6-5, 1965, Driller: FIVE COUNTY FARMERS ASSN County COAHOMA
(Name)

(1) Owner of Land: JT MASSEY
(Name)
LYON MISS
(Address)

(2) Location: 1/4, 1/4, Sec. 1 T. 1 R. 1
6 miles NE of Clarksdale
(distance) (direction) (Nearest Town)

(3) Topography: Flat
(Hilly) (Flat) (Level)

(4) Purpose of Well: Irrigation
(Domestic Irrigation
Municipal, Industrial, Other)

Description & Color of Materials Sand, Clay, Red Clay, Shell, etc.	Thick- ness Feet	Depth Feet
Clay top soil	14 1/2	14 1/2
Coarse Sand	6 1/2	21
Medium Sand	13	34
Coarse Sand & gravel	32 1/2	66 1/2
Fine Sand	6 1/2	73
Coarse Sand	6 1/2	79 1/2
Coarse water sand		
* Rock	25 1/2	105

Information upon completion of well:

(1) Diameter 6 inches.

(2) Total Depth 100 feet.

(3) Water Level 10'-8" feet below top of ground.


(4) Cased to 52, Size 6"


(5) Screen: Size 6", Length 48

(6) Were any formations sealed against pollution?
 yes, no.

If YES depth of formation _____

Why _____

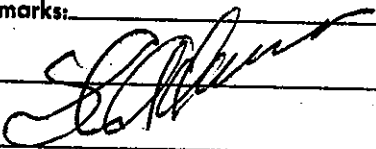Drillers Remarks:

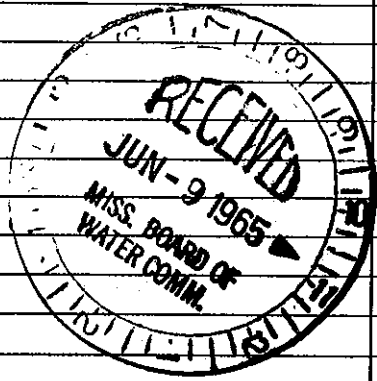


Well No.

(Use Back Side)

Mail this copy to Board of Water Commissioners 429 Miss. St. Jackson, Miss.