

**REF 18**  
5-29-64

Elev. 165

NE/SW, Sec. 33, T28N, R3W

**WATER WELL DRILLERS LOG**

**CODED**

Date: 5-29, 1964, Driller: Five County Farmers County, Cook Alabama  
(Name Allen)

(1) Owner of Land: Javolitti & Sons  
(Name)  
Clarksdale Miss  
(Address)

(2) Location: 1/4, 1/4, Sec. 4 <sup>28</sup> ~~T28N~~ R3  
4 miles North, of Clarksdale  
(distance) (direction) (Nearest Town)

(3) Topography: Flat  
(Hilly) (Flat) (Level)

(4) Purpose of Well: Irrigation  
(Domestic, Irrigation, Municipal, Industrial, Other)

Description & Color of Materials Sand, Clay, Red Clay, Shell, etc.	Thick- ness Feet	Depth Feet
<u>Buckshot 0-14's</u>	<u>14's</u>	<u>14's</u>
<u>FINE SAND and</u>	<u>6's</u>	<u>21</u>
<u>Blue Mud</u>		
<u>fine Sand + Blue</u>		
<u>Mud</u>	<u>13</u>	<u>34</u>
<u>Medium Sand</u>	<u>13</u>	<u>47</u>
<u>Coarse Sand</u>	<u>19's</u>	<u>66's</u>
<u>Coarse Sand &amp;</u>		
<u>Small gravel</u>	<u>32's</u>	<u>99</u>

Information upon completion of well:

(1) Diameter 6 inches.

(2) Total Depth 96 feet.

(3) Water Level 13 feet below top of ground.

(4) Cased to 48, Size 6


(5) Screen: Size 6, Length 48

(6) Were any formations sealed against pollution?  
\_\_\_\_\_ yes,  no.

If YES depth of formation \_\_\_\_\_

Why \_\_\_\_\_

Drillers Remarks: \_\_\_\_\_

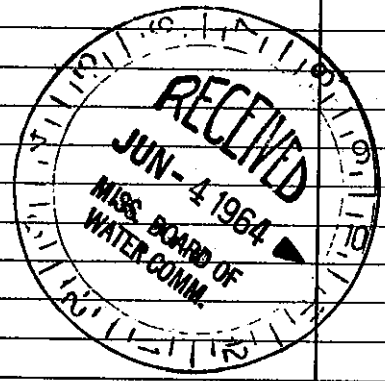

**CODED**

Well No.

(Use Back Side)