

COAHOMA

MISSISSIPPI BOARD OF WATER COMMISSIONERS

Q F 20
7-31-59

WATER WELL DRILLERS LOG

1/6/66
668

Date: July 31, 1959, Driller: Layne-Central Company County Coahoma

(Name)

High-Elementary School

(1) Owner of Land: Jonestown Junior

(Name)

Jonestown, Mississippi

(Address)

(2) Location: 1/4, 1/4, Sec. 1 T28N R3W

1 miles north of Jonestown
(distance) (direction) (Nearest Town)

(3) Topography: flat
(Hilly) (Flat) (Level)

(4) Purpose of Well: domestic
(Domestic Irrigation
Municipal, Industrial, Other)

Information upon completion of well:

(1) Diameter 6x3 inches.

(2) Total Depth 1081 feet.

(3) Water Level 5'6" feet below top of ground. 779'11" 3"

(4) Cased to 194' Size 6"
1" of 4x3 swage

(5) Screen: Size 3", Length 40'
21' lap

(6) Were any formations sealed against pollution?

yes yes, _____ no.

If YES depth of formation Mechanical seal
at top of 3" casing and B.P.V. at
Why bottom.


Drillers Remarks:

50 GPM.

Electric power.

Description & Color of Materials Sand, Clay, Red Clay, Shell, etc.	Thick- ness Feet	Depth Feet
Clay	10	10
Fine sandy clay	11	21
Fine sand	39	60
Coarse sand	15	75
Coarse sand & gravel	67	142
Gravel	8	150
Rock	1	151
Gravel	16	167
Clay	7	174
Sand	103	277
Clay	13	290
Shale, strks. of sand	65	355
Sand	22	377
Shale	13	390
Clay	50	440
Shale, strks. sandy shale	175	615
Hard shale	195	810
Shale, strks. sandy shale	95	905
Sandy shale	40	945
Sand	45	990
Sand & shale	91	1081

Case

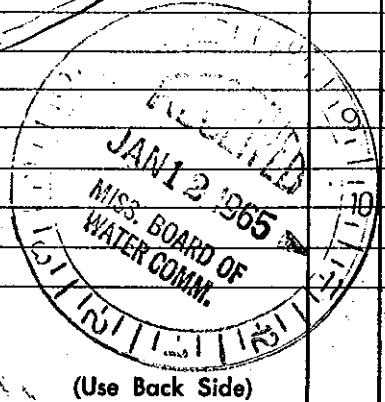

(Use Back Side)

Well No.

Mail this copy to Board of Water Commissioners 429 Miss. St. Jackson, Miss.