


**CODED**

Not Permitted

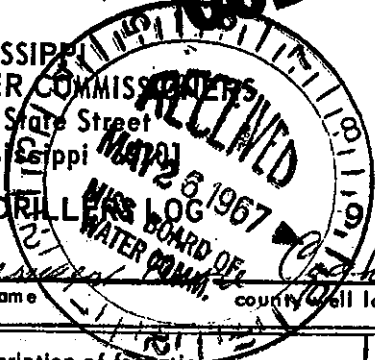

MISSISSIPPI BOARD OF WATER COMMISSIONERS  
416 North State Street  
Jackson, Mississippi

WATER WELL DRILLING PERMITS  
date well completed: 5-19-67  
firm name: Turbidity Farm  
county well located: Coahoma

Coahoma  
F27  
5-67

LANDOWNER	description of formations encountered	from	to
77 Ferguson & Son, LMC	Top soil		14
Cut well for H.S. Wilson	Clay	To	33 1/2
Clarkdale Miss (mailing address)	Clay 1/2 sand 3/4	To	40
	Sand (MED)	(13)	75 1/2
	Sand & pea rock	To	72 1/2
	Sand & fine gravel	To	79
	Sand & gravel	To	105
	Sand & large rock	To	129

WELL LOCATION:  
sec. 17 T. 28 N. R. 3 W.  
8 miles N. N.E. of Clarkdale (distance) (direction) (nearest town)

WELL PURPOSE: Irrigation (home, irrigation, municipal, industrial)

WELL COMPLETION DATA:

(1) diameter (inches) 16-18

(2) total depth (feet) 123

(3) static water level (feet) 72 below top of ground.

(4) casing Pipe 75 (material) (depth)

16-18 (size) If telescope see back.

(5) screen 48' 75' (length) (depth to top)  
1/6 Down Screen (size) (material)

(6) pump 75 gpc. 2300 (HP) (yield gpm)  
Electric (Cold Pump) (type power)

(7) electric log (yes or no)

(organization running log)

(8) how well bottom plugged Welded

37' Diameter

DRILLERS REMARKS: Excellent formation, extra large gravel & rock last 20 ft.

**CODED**