

Coahoma
F28
7-67

MISSISSIPPI
BOARD OF WATER COMMISSIONERS
416 North State Street
Jackson, Mississippi 39201

CODED

WATER WELL DRILLERS LOG

9-29-67 date well completed
Fike County Farmers Union Coahoma film name
Coahoma county well located

LANDOWNER: TO FULTON
Lyon
Miss
(mailing address)

description of formations encountered	from	to
Clay & fine sand		14
fine Red sand	14	40
Med to coarse sand	40	53
Coarse sand & gravel	53	131


WELL LOCATION:
sec. 28 T. 28 N R. 2 W
4 miles SW of Belser
(distance) (direction) (nearest town)

WELL PURPOSE: Irrigation
(home, irrigation, municipal, industrial)

WELL COMPLETION DATA:

- (1) diameter (inches) 6
- (2) total depth (feet) 125' 10"
- (3) static water level (feet) 14' 10" below top of ground.
- (4) casing Pipe 77' 10"
(material) (depth)
- 6 (size) if telescope see back.
- (5) screen 48' 77' 10"
(length) (depth to top)
- 6, Owen 101 (size) (material)
- (6) pump 30 (HP) 1000 (yield gpm)
Tractor (type power)
- (7) electric log (yes or no)
- (organization running log)
- (8) how well bottom plugged Welded

CODED

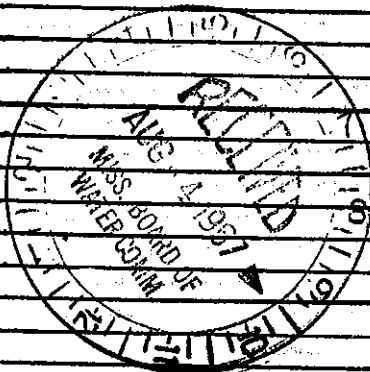

DRILLERS REMARKS: