
	State Well Report	
County: Coahoma	Part 1	For Office Use Only:
Permit #: 6W 40691	Mississippi Department of Environmental Qual	ity Aquifer:
Permit#: 09 90671 Irrigation Equipment	Office of Land and Water Resources	Well #: F - () ()
Driller:	P.O. Box 10631	
Date drilling completed: $11 - 19 - 05$	Jackson, MS 39289-0631 (601)961-5210	L. S. Elevation:
	(601)354-6938 (fax)	E-log #:
	ort be prepared by the driller in detail and fik	ed with the Department within
30 days of completion of drilling Well Owner Informa		Well Location
Owner Name Heaton Farms	Latitude: 34.16.	85N Longitude: 90. 27.02
Mailing Address: Box 158	Method of Lat/Long (circ	le one): Conventional Survey,
	USGS quad, Hand-	held GPS, Survey-grade GPS
Lyon, MS 38	3645	9 <u>Twn</u> 28N Rng 2W
City Stat	e ZipCode Distance Direction	
Telephone No. (662-624-6112	<u>3_Miles Sout</u>	h_of_Jonestown
	Well Data	·····
	-05 Date well drilling completed:	11-19-05
If flowing, method of flow regulation: Val	ve Other (describe)	
	ve Other (describe)	
	ve Other (describe) ove or below circle one) land surface Date measur	
	ove or below circle one) land surface Date measur	red: <u>11-21-05</u>
Static Water Level: <u>20'</u> feet ab Method of Measurement (circle one)	ove or below circle one) land surface Date measur	red: <u>11 - 21 - 05</u>
Static Water Level: 20' feet ab Method of Measurement (circle one) st Hole depth: 116 Well dep Type of grout (circle one): Cement	ove or below (circle one) land surface Date measure eel tape electric tape air line other:	red: <u>11-21-05</u> of <u>10</u> feet
Static Water Level: 20' feet ab Method of Measurement (circle one) st Hole depth: 116 Well dep Type of grout (circle one): Cement	ove or below (circle one) land surface Date measure cel tape electric tape air line other:	red: <u>11-21-05</u> of <u>10</u> feet
Static Water Level: 20' feet ab Method of Measurement (circle one) st Hole depth: 116 Well dep Type of grout (circle one): Cement Casing length: 76 feet Casing	ove or below (circle one) land surface Date measure eel tape electric tape air line other:	red: <u>11-21-05</u> of <u>10</u> fcet g: <u>PVC</u>
Static Water Level: 20' feet ab Method of Measurement (circle one) Static Hole depth: 116 Well dep Type of grout (circle one): Cement Casing length: 76 feet Casing	ove or below (circle one) land surface Date measure eel tane electric tape air line other:	red: <u>11-21-05</u> of <u>10</u> fcet g: <u>PVC</u>
Static Water Level: 20' feet ab Method of Measurement (circle one) st Hole depth: 116 Well dep Type of grout (circle one): Cement Casing length: 76 feet Casin Screen length: 40 feet Screet Screen slot size: 050 inches	ove or below (circle one) land surface Date measured tape electric tape air line other:	red: <u>11-21-05</u> of <u>10</u> fcet g: <u>PVC</u> a: <u>PVC</u> <u>116</u> feet Open hole Natural Development
Static Water Level: 20' feet ab Method of Measurement (circle one) st Hole depth: 116 Well dep Type of grout (circle one): Cement Casing length: 76 feet Casin Screen length: 40 feet Screet Screen slot size: 050 inches	ove or below (circle one) land surface Date measure cel tape electric tape air line other: th: 116 Well grouted to a depth of the sentonito Mix rendiameter: 12 inches Type of casing the sentonito en diameter: 12 inches Type of screet Setting depth: From 77 feet to	red: <u>11-21-05</u> of <u>10</u> fcet g: <u>PVC</u> a: <u>PVC</u> <u>116</u> feet Open hole Natural Development
Static Water Level: 20' feet ab Method of Measurement (circle one) st Hole depth: 116 Well dep Type of grout (circle one): Cement Casing length: 76 feet Casin Screen length: 40 feet Screet Screen slot size: 050 inches	ove or below (circle one) land surface Date measured tape electric tape air line other:	red: <u>11-21-05</u> of <u>10</u> fcet g: <u>PVC</u> a: <u>PVC</u> <u>116</u> feet Open hole Natural Development
Static Water Level: 20' feet ab Method of Measurement (circle one) Sh Hole depth: 116 Well dep Type of grout (circle one): Cement Casing length: 76 feet Casin Screen length: 40 feet Screet Screen slot size: 050 inches Type of completion (circle all applicable): Top of lap pipe or reduction in casing: Top of lap pipe or reduction in casing:	ove or below (circle one) land surface Date measureline electric tape air line other:	red: 11-21-05 of <u>10</u> fcet g: <u>PVC</u> h: <u>PVC</u> <u>116</u> feet Open hole Natural Development e screen, describe on back of page
Static Water Level: 20' feet ab Method of Measurement (circle one) Sh Hole depth: 116 Well dep Type of grout (circle one): Cement Casing length: 76 feet Casin Screen length: 40 feet Screet Screen slot size: 050 inches Type of completion (circle all applicable): Top of lap pipe or reduction in casing: Logs run (circle all applicable): No log run Name of organization running log(s); Screet Screet Screet	ove or below (circle one) land surface Date measurelistic case air line other:	red: 11-21-05 of 10 feet g: PVC n: PVC 116 feet Open hole Natural Development e screen, describe on back of page n Other:
Static Water Level: 20' feet ab Method of Measurement (circle one) Sh Hole depth: 116 Well dep Type of grout (circle one): Cement Casing length: 76 feet Casin Screen length: 40 feet Screet Screen slot size: 050 inches Type of completion (circle all applicable): Top of lap pipe or reduction in casing: Logs run (circle all applicable): No log run Name of organization running log(s); Screet Screet Screet	ove or below (circle one) land surface Date measurel tape electric tape air line other:	red: 11-21-05 of 10 feet g: PVC n: PVC 116 feet Open hole Natural Development e screen, describe on back of page n Other:
Static Water Level: 20' feet ab Method of Measurement (circle one) st Hole depth: 116 Well dep Type of grout (circle one): Cement Casing length: 76 feet Casin Screen length: 40 feet Screet Screen slot size: 050 inches Type of completion (circle all applicable): Top of lap pipe or reduction in casing: Logs run (circle all applicable): No log run Name of organization running log(s): I certify that the well was drilled, construction Screet	ove or below (circle one) land surface Date measurelistic case air line other:	red: 11-21-05 of <u>10</u> fcet g: <u>PVC</u> a: <u>PVC</u> <u>116</u> feet Open hole Natural Development e screen, describe on back of page n Other: able requirements of the Mississip
Static Water Level: 20' feet ab Method of Measurement (circle one) st Hole depth: 116 Well dep Type of grout (circle one): Cement Casing length: 76 feet Casin Screen length: 40 feet Screet Screen slot size: 050 inches Type of completion (circle all applicable): Top of lap pipe or reduction in casing: Logs run (circle all applicable): No log run Name of organization running log(s): I certify that the well was drilled, construction Screet	ove or below (circle one) land surface Date measurel tance electric tape air line other:	red: 11-21-05 of <u>10</u> fcet g: <u>PVC</u> a: <u>PVC</u> <u>116</u> feet Open hole Natural Development e screen, describe on back of page n Other: able requirements of the Mississip

DEC 0 5 2005 BY: OLWR If well telescopes please sketch below and show depths.

Ground Level

Description of Formations Encountered	From	То
Clay	0	21
Fine Sand Fine Sand/gravel Med. Sand/gravel	22	35
Fine Sand/gravel	36	51
Med. Sand/gravel	52	116
	ļ	
· · · · · · · · · · · · · · · · · · ·		
······································	 	
	 	
······································		
		
······································		
	<u> </u>	
	+	
	1	
	1	
	<u>† </u>	
	1	
	1	

If more than one screen, show location of each on sketch

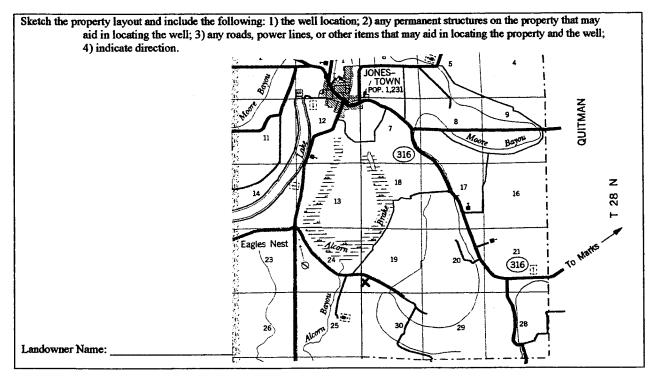

Signature of Water Well Contractor

STATE WELL REPORT			
county: Coahoma	Part 2 Pump Installer's Completion Report	For Office Use Only:	
Permit#: <u>6W 4069/</u> Irrigation Equipment		Aquifer:	
Irrigation Equipment	Inc. P.O. Box 10631 Jackson, MS 39289-0631	well #: <u>F-) /</u>	
Date completed: $11 - 21 - 05$	(601)961-5210 (601)354-6938 (fax)	Elevation:	

• • • • •

This report should be prepared by the pump installer in detail and filed with the Department within 30 days of the installation of pump.

	Well Owner Info			Well Location	
Owner Name:	Heaton Far	ms	Latitude:	Longitude:	
Mailing Address: Box 158		Method of Lat/Lor	ng (circle one): Conventi	ional Survey,	
			USGS	quad, Hand-held GPS, S	Survey-grade GPS
	Lyon MS			4 Sec_19_Twn_2	28N _{Rng} 2W
	City St	ate Zip Code	Distance I	Direction Nearest	Town
Telephone No. (_			<u> </u>	outh of Jones	stown
	Pump Typ Circle one			Power Type	
	Circle one			Circle one	
Air Lift	Jet	Submersible	Desel Engine	Circle one Gasoline Engine	Natural Gas
Air Lift Bucket			Desel Engine Electric Motor	Gasoline Engine	Natural Gas Tractor PTO
	Jet	Submersible		Gasoline Engine Hand	Tractor PTO
Bucket Centrifugal	Jet Piston	Submersible Turbine Flowing Well	Electric Motor Windmill	Gasoline Engine Hand	Tractor PTO
Bucket Centrifugal Other (specify): _	Jet Piston Rotary	Submersible Turbine Flowing Well	Electric Motor Windmill Horse Power Ratin	Gasoline Engine Hand Other (specify):	Tractor PTO

Pump Test Data	Method of Measuring Water Level Circle one		
Date Well Tested:			
Static Water Level (A):Feet Below Land Surface	Air Line Electric Measuring Line Steel Tape		
Pumping Water Level (B):Feet Below Land Surface	Other (specify):		
Drawdown [(B) – (A)]:Feet Below Land Surface	For flowing well, measured shut in head:feet		
Test Pumping Rate:Gallons Per Minute	Well yielded GPM with a drawdown of		
Duration of Pump Test (minimum 4 hours):hours	feet afterhours of pumping		

I HEREBY CERTIFY that the above statements are true to the bes	t of my mwicAge.
Patrick M. Chism 0695	later MChin
Print Name of Pump Installer and License No. (if applicable)	Signature of Pump Installer

DEC 0 5 2005 BY: OLWR