

lat/long 20.45 mi SE of permit loc.

10-237

Part 2 never received 3/13

County: Cochise
 Permit #: GW-44069
 Driller: Pete Sappington
 Date drilling completed: 6-29

State Well Report
Part 1 - Driller's Log
 Mississippi Department of Environmental Quality
 Office of Land and Water Resources
 P.O. Box 2309
 Jackson, MS 39225
 (601)961- 5210
 (601)961- 5228 (fax)

For Office Use Only:
 Aquifer: F108
 Well #: _____
 L. S. Elevation: _____
 E-log #: _____

State Law requires that this report be prepared by the license holder responsible for the work and filed with the Department at the above address within 30 days of completion of drilling of the well or borehole.

Information on Well Owner (Landowner if borehole is not for a water well)	Well or Borehole Location
Owner Name: <u>Joe Nae Nae Farms</u>	Latitude: <u>34° 16' 57.4" N</u> Longitude: <u>90° 30' 51.2" W</u>
Mailing Address: <u>245 East Lee Dr.</u>	Method of Lat/Long (circle one): Conventional Survey, USGS quad, <u>Hand-held GPS</u> , Survey-grade GPS
<u>Clarksdale Ms. 38614</u>	<u>NE 1/4 SW 1/4 Sec 21 Twn 28N Rng 3W</u>
City State Zip Code	Distance Direction Nearest Town <u>3 Miles N of Clarksdale</u>
Telephone No. <u>(662) 624-5863</u>	

Well / Borehole Data

Date drilling started: 6-28 Date drilling completed: 6-29 Hole depth: 100' Hole diameter: 18"

Location of the source of any surface water used for drilling: Card west of well

Method of dosing and volume of Chlorine used in drilling and development: Sodium Hypo - Chlorite @ 10 ppm

Logs run (circle all applicable): No log run Electric Gamma Ray Density Sonic Neutron Other: _____

Name of organization running log(s): _____

Purpose of borehole (check one): Water Well Geotechnical/Geological Investigation _____ Ground Source Heat Pump _____
 Seismic Survey _____ Other (describe) _____

If drilling is not related to water well construction, skip the remainder of this block

Purpose of Well (check one): Home _____ Industrial _____ Public Supply _____ Irrigation Fish Culture _____ Other: _____

If a flowing well, method of flow regulation: Valve _____ Other (describe) _____

Static Water Level: 24 feet above or below (circle one) land surface Date measured: 6-30

Method of Measurement (circle one) steel tape electric tape air line other: _____

Well depth: 100 Well grouted to a depth of 10 feet Type of grout (circle one): Neat Cement Bentonite Mix

Casing length: 60 feet Casing diameter: 12 inches Type of casing: PVC Sch 40

Screen length: 40 feet Screen diameter: 12 inches Type of screen: PVC Sch 40

Screen slot size: .032 inches Setting depth: From 60 feet to 100 feet

Type of completion (circle all applicable): Gravel packed Underreamed Telescoped Open hole Natural Development
 Other (describe): _____


Top of lap pipe or reduction in casing: _____ feet. *If telescoped or more than one screen, describe on next page*

Form: OLWR-SWB-1001
RECEIVED
 JUL 21 2010
 BY: OLWR

The sketch below only required for water wells

If well telescopes, show depths on sketch.

Ground Level →

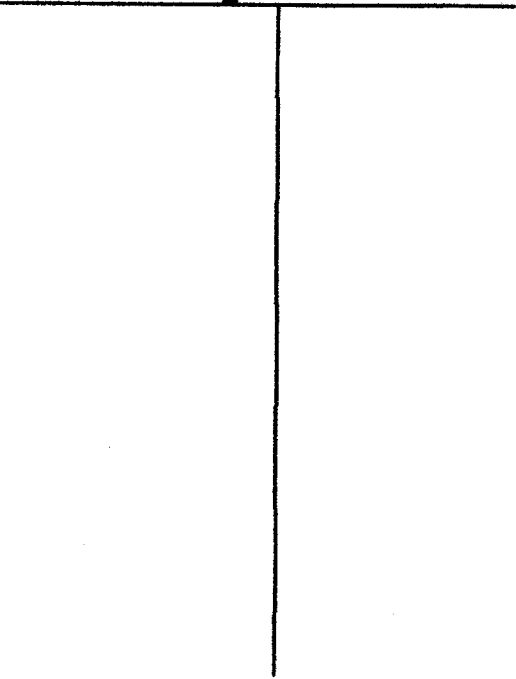

Description of formations encountered must be provided for all wells and boreholes, unless specifically exempted by regulations

Description of Formations Encountered	From (depth) Ground Level	To (depth)
Clay	0	28
Fine Sand	28	32
Coarse Sand & Gravel	32	100

If more than one screen, show location of each on sketch

Sketch the property layout and include the following: 1) the well location; 2) any permanent structures on the property that may aid in locating the well; 3) any roads, power lines, or other items that may aid in locating the property and the well; 4) a north arrow.

See Map Attached

Landowner Name: Joe Noe


Form: OLWR-SWR-1A (04/08)

I certify that the well/borehole was drilled, constructed, and completed in accordance with all applicable requirements of the Mississippi Department of Environmental Quality and the Mississippi Department of Health regulations, if applicable, and state laws.

Print Name of Responsible Licensee and License No. Pete Springer 0430 Date 6-30

Pete Springer
Signature of Licensee
RECEIVED JUL 21 2010

BY: OLWR BY: OLWR

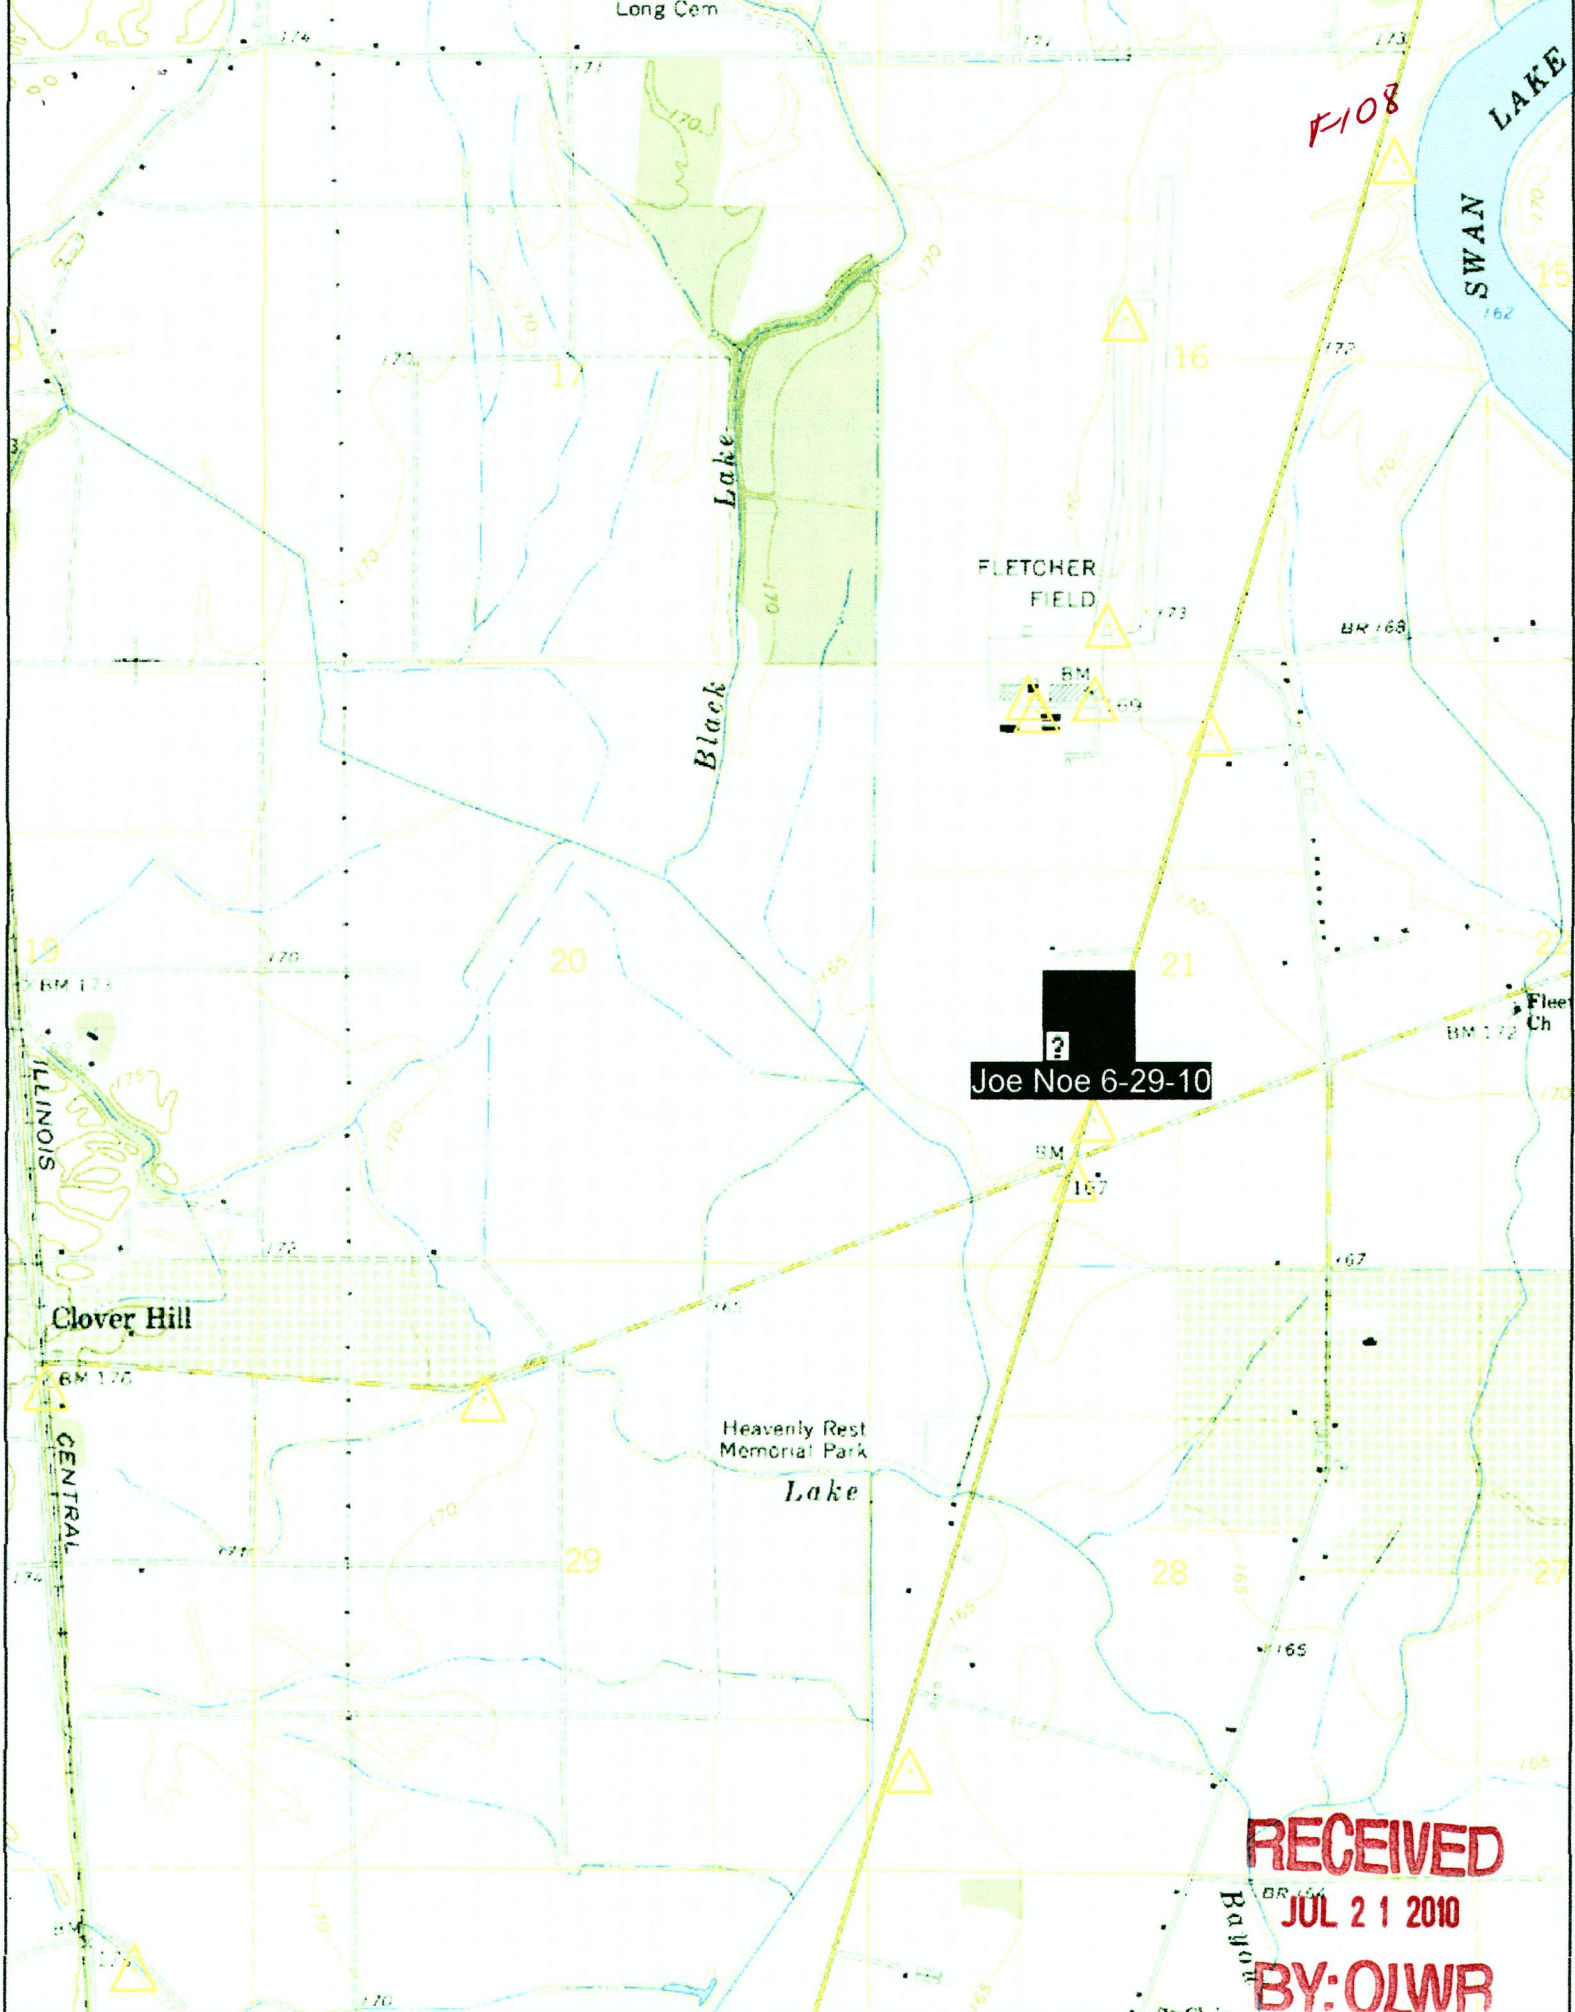

F108

FLETCHER FIELD

Joe Noe 6-29-10

RECEIVED
JUL 21 2010
BY: OLWR