
	State Well Report	The Charles Line Chairs			
Couply: Coan owner	Part 1 Driller's Log				
Pennis 4: 44781	Mississippi Department of Environmental Quality				
	Office of Land and Water Resources	Well #			
Driller: Will Young	P.O. Box 1063! Jackson, MS 39289-0631	L. S. Blevation:			
Dute drilling completed 10-10-11	(601)961-5210	L. S. Bievanog:			
	(601)354-6938 (fax)	E-log #:			
State Law requires that this report be prepared by the license holder responsible for the work and filed with the Department at the above address within 30 days of completion of drilling of the well or borehole.  Information on Well Owner  Well or Borehole Location					
A	(Landorunar if borehale is not for a water well)  Laritude: 34 - 17 - 56 Longitude: 90 - 33 - 03				
Owner Name Tucks Mass	one): Conventional Survey,				
Mailing Address: 5 Bridge Street  USCIS quad Manding Core Conveniences. Survey-grade CPS					
SW, NW, Sec 18 Ton 28N Rng 3 W					
City State Zip Code Distance Direction Mearest Town					
Telephone No. ()					
	Well / Borehole Data				
Date drilling started: Lelloft Date drilling completed 6/10/11 Hole depth. 135 Hole diameter. 24					
Location of the source of any surface water used for drilling Ditch  Method of dosing and volume of Chlorine used in drilling and development:					
Logs run (circle all applicable): No log run Electric Garrons Ray Density Sonic Neutron Other Name of organization running log(s):					
Purpose of borehole (check one): Water WellGeotechnical/Geological Investigation Oround Source Heat Pump					
Seismic StuveyOther (describe)					
If drilling is not related to water well construction, skip the remainder of this block					
Purpose of Well (check one): Home Industrial Public Supply Irrigation Fish Culture Other:					
tf a flowing well, method of flow regulation: Valve Other (describe)					
Static Water Level: 20 feet above or below (circle one) land surface Date measured: 6 10 11					
Method of Measurement (circle one) spellage electric tape air line other:					
Well depth: 135 Well grouted to a depth offeet Type of grout (circle one): Neat Gement Sentonite Mix					
Cusing length: 95 feet Casing diaracter: 12 inches Type of casing: DVC					
Screen length: 40 feet Screen diameter: 12 inches Type of screen: PVC  Screen slot size: .050 inches Setting depth: From 95 feet to 135 feet					
Type of completion (circle all applicable): Grave packed Underreamed Telescoped Open hole Natural Development					

feet. If telescoped or more than one screen, describe on next page

Top of lap pipe or reduction in casing:

The sketch	below	only	required	for	ıvater	wells

If well telescopes, show depths on sketch.

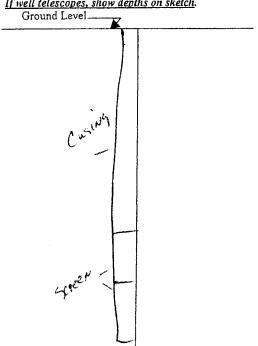

## Description of formations encountered must be provided for all wells and boreholes, unless specifically exempted by regulations

Description of Formations Encountered	From (depth)	To (depth)
Gunbo	Ground Level	33
Fine Soud	3.3	73
Coase Sand	7.3	90
Course Sand Granel	90	135
		l
		<u> </u>
A CONTRACTOR OF THE CONTRACTOR		1
	1	
	<del> </del>	1
	<del> </del>	1
		<del> </del>
	I	

If more than one screen, show location of each on sketch

Sketch the property layout and include the following: 1) the well location; 2) any permaraid in locating the well; 3) any roads, power lines, or other items that may a 4) a north arrow.  Massey Rel	Hwy b
Landowner Name:	Clarksdale Form: OLWR-SWR-1

I certify that the well/borehole was drilled, constructed, and completed in accordance with all applicable requirements of the Mississippi Department of Environmental Quality and the Mississippi Department of Health regulations, if applicable, and state

Print Name of Responsible Licensee and License No.

	TE WELL REPORT
Permit #:	Part 2 Installer's Completion Report Department of Environmental Quality e of Land and Water Resources P.O. Box 10631 Jackson, MS 39289-0631 (601)961-5210 (601)354-6938 (fax)  Section Report  Aquifer:  MS Liver Lilluvia  Well #:  Elevation:  Elevation:  Mater well contractor or a licensed pump installer. A copy of Part 1 of the
report must be attached and both parts filed with the Depo	artment at the above address within 30 days of well completion.  Well Location
Owner Name: Turner Massey  Mailing Address: 5 Bridge Street  Lich Ms. 38617  City State Zip Code	Latitude: 34-17-94 Longitude: 90-33-94  Method of Lat/Long (check one): Conventional Survey,  USGS quad (Hand-held GPS), Survey-grade GPS  Sw / Nw / Sec_18_T_38N_R_3W
Telephone No()	Distance Direction Nearest Town  7 Miles NW of Clark Sdp/c
Pump Type Circle one	Power Type Circle one
Air Lift Jet Submersible	Diesel Enguie Gasoline Engine Natural Gas
Bucket Piston Turbine	Electric Motor Hand Tractor PTO
Centrifugal Rotary Flowing Well	Windmill Other (specify):
Other (specify):  Date Pump Installed:	Horse Power Rating of Motor: 60 Age  Setting Depth: 60 feet  Number of Stages: 2
Pump Test Data  Date Well Tested: (0/10/1)  Static Water Level (A): Feet Below Land Surface  Pumping Water Level (B): Feet Below Land Surface	Other (enecify):
Drawdown [(B) - (A)]:Feet Below Land Surface	
Test Pumping Rate: 2.500 Gallons Per Minut  Duration of Pump Test (minimum 4 hours): 4 hours	or in white diawdown of
HEREBY CERTIFY that the above statements are true to the frint Name of Pump Installer and License No. (if applicable)	best of my knowledge.  Signature of Pump Installer