

County Coahoma
 Permit # GW-48429
 Driller JEDDY Coats
 Date drilling completed 7-12-14

State Well Report
 Part I - Driller's Log
 Mississippi Department of Environmental Quality
 Office of Land and Water Resources
 P.O. Box 2309
 Jackson, MS 39225
 (601)961- 5210
 (601)961- 5228 (fax)

For Office Use Only:
 Aquifer: _____
 Well # F125
 L. S. Elevation _____
 E-log #: _____

State Law requires that this report be prepared by the license holder responsible for the work and filed with the Department at the above address within 30 days of completion of drilling of the well or borehole.

<p>Information on Well Owner (Landowner if borehole is not for a water well)</p> <p>Owner Name <u>RODGER RODGERS</u> Mailing Address: <u>RODGER RODGERS</u> <u>10 CYPRESS RIDGE RD.</u> <u>CLARKSBLE MS 38614</u> City State Zip Code Telephone No. () _____</p>	<p>Well or Borehole Location</p> <p>Latitude: <u>34° 19' 18"</u> Longitude: <u>90° 35' 01"</u> Method of Lat/Long (circle one): Conventional Survey. USGS quad, Hand-held GPS, Survey-grade GPS <u>SW</u> <u>SW</u> <u>Sec 06</u> <u>Twn 28N</u> <u>Rng 03W</u> Distance <u>6</u> Miles <u>N</u> Direction of <u>Byon</u> Nearest Town</p>
--	---

Well / Borehole Data

Date drilling started: 7-12-14 Date drilling completed: 7-12-14 Hole depth: 110 Hole diameter: 28

Location of the source of any surface water used for drilling: nearest well
 Method of dosing and volume of Chlorine used in drilling and development: _____

Logs run (circle all applicable): No log run Electric Gamma Ray Density Sonic Neutron Other: _____
 Name of organization running log(s): _____

Purpose of borehole (check one): Water Well Geotechnical/Geological Investigation _____ Ground Source Heat Pump _____
 Seismic Survey _____ Other (describe) _____
If drilling is not related to water well construction, skip the remainder of this block

Purpose of Well (check one): Home _____ Industrial _____ Public Supply _____ Irrigation Fish Culture _____ Other: _____

If a flowing well, method of flow regulation: Valve _____ Other (describe) _____

Static Water Level: 25 feet above or below (circle one) land surface Date measured: 7-12-14

Method of Measurement (circle one) steel tape electric tape air line other: _____

Well depth: 110 Well grouted to a depth of 10 feet Type of grout (circle one): Neat Cement Bentonite Mix
 Casing length: 70 feet Casing diameter: 050 inches Type of casing: P.V.C
 Screen length: 40 feet Screen diameter: _____ inches Type of screen: P.V.C
 Screen slot size: 050 inches Setting depth: From 0 feet to 70 feet

Type of completion (circle all applicable): Gravel packed Underreamed Telescoped Open hole Natural Development
 Other (describe): _____


Top of lap pipe or reduction in casing: _____ feet. *If telescoped or more than one screen, describe on next page*

Form: OLWR-SWR-1A (04/08)

RECEIVED
 AUG 07 2014
 BY: OLWR

The sketch below only required for water wells.

If well telescopes, show depths on sketch.

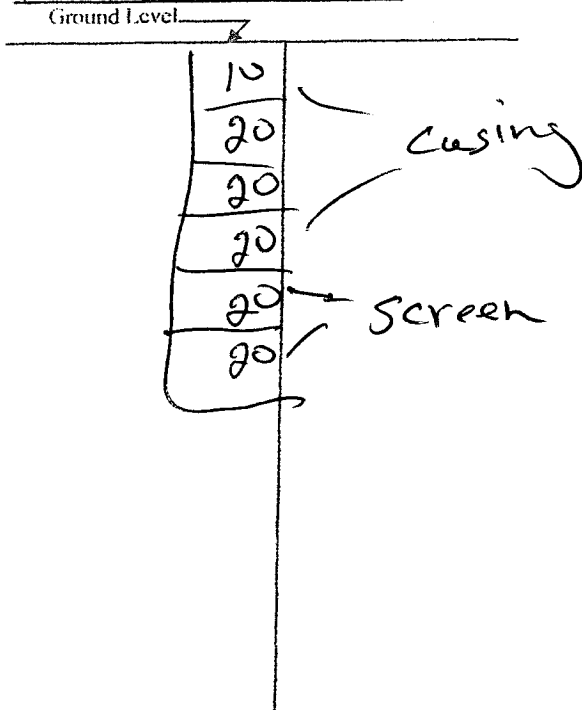

Description of formations encountered must be provided for all wells and boreholes, unless specifically exempted by regulations.

Description of Formations Encountered	From (depth)	To (depth)
	Ground Level	10
Dirt	10	20
Dirt	20	40
sand	40	60
sand	60	80
gravel	80	100
gravel	100	120

If more than one screen, show location of each on sketch

Sketch the property layout and include the following: 1) the well location; 2) any permanent structures on the property that may aid in locating the well; 3) any roads, power lines, or other items that may aid in locating the property and the well; 4) a north arrow.

Landowner Name: Rodger Rodgers

Form: OI.WR-SWR-1A (04/08)


I certify that the well/borehole was drilled, constructed, and completed in accordance with all applicable requirements of the Mississippi Department of Environmental Quality and the Mississippi Department of Health regulations, if applicable, and state laws.

TEDDY LOUIS #5318 7-12-14
 Print Name of Responsible Licensee and License No. Date

Judy RECEIVED
 Signature of Licensee

AUG 07 2014
 BY OIWR

F125

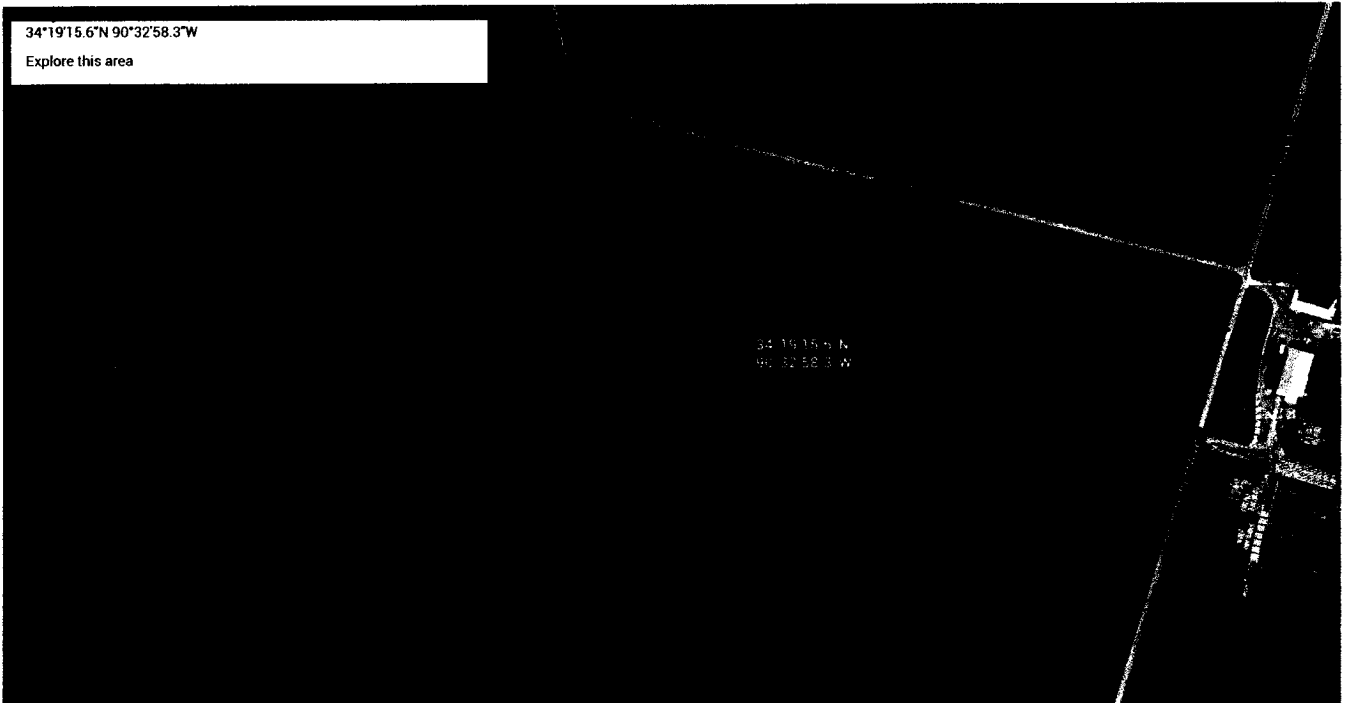

RECEIVED
JUL 24 2014
FBI - OMAHA

STATE WELL REPORT

Part 2

Pump Installer's Completion Report
 Mississippi Department of Environmental Quality
 Office of Land and Water Resources
 P.O. Box 2309
 Jackson, MS 39225-2309
 (601)961-5210
 (601) 360-0535 (fax)

For Office Use Only:

Well #: _____

Aquifer: _____

County: COAHONDA
 Permit #: GW-48429
 Driller: SOLTED WELL SERVICE
 Date completed: 7-12-14
Copy information from block on Part 1

This part of the report must be completed by a licensed water well contractor or a licensed pump installer. A copy of Part 1 of the report must be attached and both parts filed with the Department at the above address within 30 days of well completion.

Well Owner Information	Well Location
Owner Name: <u>RODGER'S PUG CO</u>	Latitude: <u>34° 19' 16.7"</u> Longitude: <u>90° 32' 59.7"</u>
Mailing Address: <u>10 CYPRESS DR</u>	Method of Lat/Long (check one): Conventional Survey _____
<u>CLARESDALE</u> <u>MS</u> <u>38644</u>	USGS quad _____, Hand-held GPS _____, Survey-grade GPS _____
City State Zip Code	<u>SW 1/4 SW 1/4</u> , Sec <u>06</u> T <u>28N</u> R <u>03W</u>
Telephone No. <u>(601) 624-2478</u>	<u>3.1</u> Miles <u>N</u> of <u>CLOVER HILL</u>
	(Distance) (Direction) (Nearest Town)

Pump Type (circle one)

Submersible Turbine Air Lift Centrifugal Flowing Well Jet Piston Rotary Other (describe): _____

Date Pump Installed: 7-13-14 Rated Pump Capacity: 1600 Gallons Per Minute

Is This Pump (circle one): New Repaired Replacement USED

Power Type (circle one)

Electric Diesel Gasoline Natural Gas Tractor PTO Windmill Other (describe): _____

Horse Power Rating of Motor: 60 Setting Depth: 60 feet Number of Stages: 2

Pump Test Data for Non Flowing Well

Date Well Tested: _____ Duration of Pump Test (minimum 4 hours): _____ hours

Static Water Level (A): _____ Feet Below Land Surface Pumping Water Level (B): _____ Feet Below Land Surface

Drawdown [(B) - (A)]: _____ Feet Below Land Surface Test Pumping Rate: _____ Gallons Per Minute

Method of measurement (circle one): Steel tape Electric tape Air line Other (describe): _____

Pump Test Data for Flowing Well

Measured shut in head: _____ feet.

Well yielded _____ GPM with a drawdown of _____ feet after _____ hours of pumping

Meter Installation

Meter Manufacturer: N/A Meter Serial Number: _____

Meter Model Number/Name: _____ Type of Meter: _____

Totalizer Register Unit and Multiplier Factor (AF x .001, gal x 1000, etc): _____

Installation Date: _____ Meter installed by: _____

Is This Meter (circle one): New Repaired Replacement

Important: By submitting the above information you are certifying that this meter was installed to manufacturer standards. For agricultural wells, a list of approved meters is on the MDEQ website.

RECEIVED

JUL 28 2014

BY: OLWR

I HEREBY CERTIFY that the above statements are true to the best of my knowledge.

DAVID P. HOLT 0-752 P 7-24-14 _____

Print Name of Pump Installer and License No. (if applicable) Date Signature of Pump Installer

140502