

COAHOMA MISSISSIPPI BOARD OF WATER COMMISSIONERS

F 2000


3-31-65

WATER WELL DRILLERS LOG

QUITMAN?

Date: 3-31, 1965, Driller: FIVE COUNTY FARMERS ASSN COAHOMA
 (Name)

(1) Owner of Land: <u>L. J. Barksdale</u> (Name)	Description & Color of Materials Sand, Clay, Red Clay, Shell, etc.	Thick- ness Feet	Depth Feet
<u>MARKS RED MISS</u> (Address) <u>34 28 2W</u>	<u>TOP SOIL + CLAY</u>		<u>14 1/2</u>
(2) Location: <u>1/4, 39, 10, 11, 14, Sec 12, 15 T22R 2W</u>	<u>FINE SAND</u>	<u>13</u>	<u>27 1/2</u>
<u>12</u> miles <u>NE</u> of <u>Clarksdale</u> (distance) (direction) (Nearest Town)	<u>COARSE SAND</u>	<u>13</u>	<u>40 1/2</u>
(3) Topography: <u>Flat</u> (Hilly) (Flat) (Level)	<u>COARSE SAND AND</u>		
(4) Purpose of Well: <u>Irrigation</u> (Domestic, Irrigation, Municipal, Industrial, Other)	<u>SMALL GRAVEL -</u>		
	<u>SOME ROCK</u>	<u>65</u>	<u>105 1/2</u>

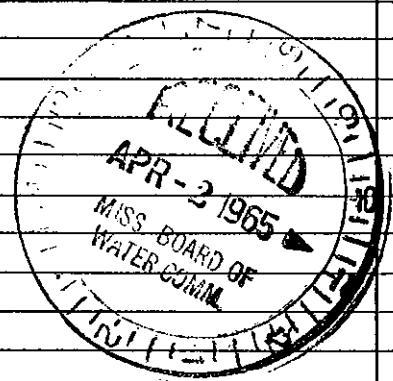

Information upon completion of well:

(1) Diameter 14 inches.

(2) Total Depth 99 feet.

(3) Water Level 16 1/2 feet below top of ground.

(4) Cased to 59', Size 14"

(5) Screen: Size 14", Length 40'

(6) Were any formations sealed against pollution?
 _____ yes, no.

If YES depth of formation _____

Why _____

Drillers Remarks: _____

Well No.

(Use Back Side)

Mail this copy to Board of Water Commissioners 429 Miss. St. Jackson, Miss.