


COAHOMA MISSISSIPPI BOARD OF WATER COMMISSIONERS

F 2001
7-30-65

WATER WELL DRILLERS LOG

Date: 7-30, 1965, Driller: Five Corners Drillers County: Coahoma
(Name)

(1) Owner of Land: <u>VINCENT MALAVAS</u> (Name)	Description & Color of Materials Sand, Clay, Red Clay, Shell, etc.	Thick- ness Feet	Depth Feet
<u>RFD MARKS MISS</u> (Address) <u>1, 12 26 20</u>	<u>Grey Clay + Top Soil</u>		<u>14 1/2</u>
(2) Location: <u>1/4, 1/4, Sec. 22 T27R1W</u>	<u>Grey Clay</u>	<u>6 1/2</u>	<u>21</u>
<u>12 miles East</u> of <u>Clarksdale</u> (distance) (direction) (Nearest Town)	<u>Soft Blue Clay (Sandy)</u>	<u>6 1/2</u>	<u>27 1/2</u>
(3) Topography: <u>flat</u> (Hilly) (Flat) (Level)	<u>Soft Blue Clay Sandy</u>	<u>6 1/2</u>	<u>34</u>
(4) Purpose of Well: <u>Irrigation</u> (Domestic, Irrigation, Municipal, Industrial, Other)	<u>Med. Sand + Clay (Streaks)</u>	<u>6 1/2</u>	<u>40 1/2</u>
Information upon completion of well:	<u>Med. Grey Sand</u>	<u>6 1/2</u>	<u>47</u>
(1) Diameter <u>14</u> inches.	<u>Med. Grey Sand + Pea rock</u>	<u>3 1/2</u>	<u>77 1/2</u>
(2) Total Depth <u>118 1/2</u> feet.	<u>Med. Grey Sand</u>	<u>6 1/2</u>	<u>86</u>
(3) Water Level <u>10' 2"</u> feet below top of ground.	<u>Med. Grey Sand, lignite +</u>	<u>6 1/2</u>	<u>92 1/2</u>
(4) Cased to <u>58 ft</u> , Size <u>14</u>	<u>Pea gravel</u>		
(5) Screen: Size <u>14</u> , Length <u>48</u>	<u>Med. Grey Sand + large</u>	<u>6 1/2</u>	<u>99</u>
(6) Were any formations sealed against pollution?	<u>gravel</u>		
_____ yes, _____ no.	<u>Coarse Sand + Gravel</u>		<u>118 1/2</u>
If YES depth of formation _____			
Why _____			
Drillers Remarks:			
<u>[Signature]</u>			

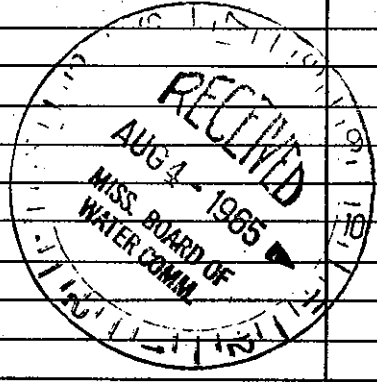

Well No.

(Use Back Side)

Mail this copy to Board of Water Commissioners 429 Miss. St. Jackson, Miss.