


LOAHOMA MISSISSIPPI BOARD OF WATER COMMISSIONERS

F 2662
2-15-65

WATER WELL DRILLERS LOG

Date: 2/15, 1965, Driller: Baley Drilling Co. 100 Washington

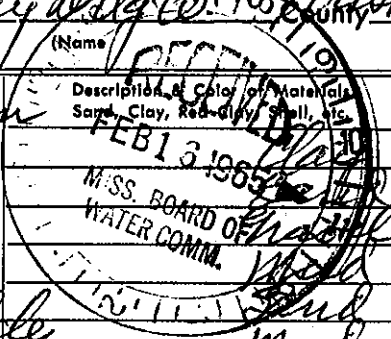

(1) Owner of Land:	Description of Material Sand, Clay, Red-dirt, Shell, etc.	Thick- ness Feet	Depth Feet
<u>H. J. McMillan</u> (Name) <u>Clarksdale Miss.</u> (Address) 16 26 3			18
(2) Location: <u>1/4</u> , <u>1/4</u> , Sec. <u>11</u> T <u>25</u> R <u>3</u>			82
<u>6</u> miles <u>N</u> of <u>Clarksdale</u> (distance) (direction) (Nearest Town)			140
(3) Topography: <u>Flat</u> (Hilly) (Flat) (Level)			180
(4) Purpose of Well: <u>domestic</u> (Domestic Irrigation Municipal, Industrial, Other)			205
	<u>Sand</u>		611
	<u>Mud</u>		650
	<u>Sand</u>		984
	<u>Mud + rocks</u>		1076
	<u>Sand</u>		

Information upon completion of well:

- (1) Diameter: 3 X 2 1/2 inches.
- (2) Total Depth: 1076 feet.
- (3) Water Level: 12 feet below top of ground.
- (4) Cased to: all way Size 3 X 2 1/2
- (5) Screen: Size 2 1/2, Length 30 ft.
- (6) Were any formations sealed against pollution?
 yes, no.

If YES depth of formation _____

Why _____

Drillers Remarks: _____

Well No.

(Use Back Side)

Mail this copy to Board of Water Commissioners 429 Miss. St. Jackson, Miss.