

MISSISSIPPI  
 BOARD OF WATER COMMISSIONERS  
 416 North State Street  
 Jackson, Mississippi 39201

WATER WELL DRILLERS LOG

Coahoma  
G 11  
8-68

8-30-68 date well completed Franklin's Drilling Service firm name Coahoma county well located

LANDOWNER: Book P Rice  
Clarksdale Miss  
 (mailing address)


description of formations encountered	from	to
<u>Clay</u>		<u>50'</u>
<u>fine sand</u>		<u>65'</u>
<u>Coarse sand &amp; pea gravel</u>		<u>105'</u>

WELL LOCATION:  
 sec. 9 T. 26 N. R. 6 W.  
3 miles West of Renalava  
 (distance) (direction) (nearest town)

WELL PURPOSE: Domestic  
 (home, irrigation, municipal, industrial)

- WELL COMPLETION DATA:
- (1) diameter (inches) 2 1/2
  - (2) total depth (feet) 93
  - (3) static water level (feet) 44 below top of ground.
  - (4) casing 4 1/2" 84'  
 (material) (depth)  
2 if telescope see back.  
 (size)
  - (5) screen 2 x 9" 84'  
 (length) (depth to top)  
2 Brass Wuffed  
 (size) (material)
  - (6) pump 1 Electric  
 (HP) (yield gpm)  
 (type power)
  - (7) electric log NO  
 (yes or no)
  - (organization running log)
  - (8) how well bottom plugged Point

*Well Drilled Through  
 Old Levee*

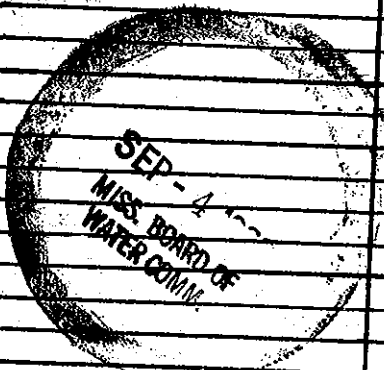

DRILLERS REMARKS: