


COAHOMA MISSISSIPPI BOARD OF WATER COMMISSIONERS

H0003

3-31-64

WATER WELL DRILLERS LOG

Date: Mar 31 1964, Driller: FIVE COUNTY FARMERS ASSOCIATION County: WALTON MISSISSIPPI  
 (Name)

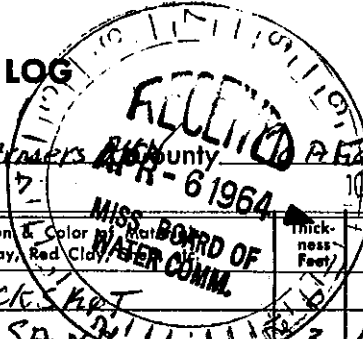

(1) Owner of Land: W H STOVALL (Name)  
STOVALL MISS (Address)

(2) Location: 1/4, 1/4, Sec.     T.     R.      
5 miles West of Chukchee (Nearest Town)  
 (distance) (direction)

(3) Topography: Flat + low  
 (Hilly) (Flat) (Level)

(4) Purpose of Well: Irrigation  
 (Domestic Irrigation, Municipal, Industrial, Other)

Description & Color of Sand, Clay, Red Clay	Thickness Feet	Depth Feet
<u>BUCKSHOT</u>	<u>3</u>	<u>3</u>
<u>Red SAND</u>	<u>14 1/2</u>	<u>17 1/2</u>
<u>COARSE SAND + Pea gravel</u>	<u>14 1/2</u>	<u>32</u>
<u>COARSE SAND</u>	<u>21</u>	<u>53 1/2</u>
<u>COARSE SAND + Pea Rock</u>	<u>27 1/2</u>	<u>81</u>
<u>almost solid Pea rock</u>	<u>60</u>	<u>141 1/2</u>
<u>BLUE MUD</u>	<u>66 1/2</u>	<u>208</u>
<u>Some Sand</u>	<u>   </u>	<u>   </u>
<u>SAND COARSE + FINE</u>	<u>73</u>	<u>281 1/2</u>
<u>COARSE SAND</u>	<u>79 1/2</u>	<u>361</u>
<u>COARSE SAND + GRAVEL</u>	<u>86</u>	<u>447 1/2</u>
<u>sand + large Rock</u>	<u>72 1/2</u>	<u>520</u>

Information upon completion of well:

(1) Diameter 6 inches.

(2) Total Depth 95' feet.

(3) Water Level 8' feet below top of ground.

(4) Cased to 47', Size 6"

(5) Screen: Size 6", Length 48"

(6) Were any formations sealed against pollution?  
    yes,  no.

Well set at 95'  
Due to 5' core in

Water table 8'

W H Stovall HQ

across Road on  
new County Road.

If YES depth of formation    

Why    

Drillers Remarks:    

(Use Back Side)

Well No.

Mail this copy to Board of Water Commissioners 429 Miss. St. Jackson, Miss.