

COAHOMA MISSISSIPPI BOARD OF WATER COMMISSIONERS

H 0004
3-23-64

WATER WELL DRILLERS LOG

Date: 3-23, 1964, Driller: FIVE COUNTY FARMERS County COAHOMA
(Name 1755N)

(1) Owner of Land: <u>STOVALL FARMS</u> (Name)	Description & Color of Materials Sand, Clay, Red Clay, Shell, etc.	Thick- ness Feet	Depth Feet
<u>STOVALL MISS</u> (Address)	0-14's Bunches		14 1/2
(2) Location: _____ 1/4, _____ 1/4, Sec. _____ T. _____ R. _____	FINE RED SAND	6 1/2	21
<u>5</u> miles <u>West</u> of <u>Chickasha</u> (distance) (direction) (Nearest Town)	FINE SAND	13'	34
(3) Topography: <u>Flat</u> (Hilly) (Flat) (Level)	Coarse sand & large gravel	20'	54
(4) Purpose of Well: <u>Irrigation</u> (Domestic Irrigation Municipal, Industrial, Other)	Coarse Sand + Small gravel	19	73
	Very Coarse Sand and Varied Size gravel + Pea Rock	37 1/2	110 1/2

Information upon completion of well:


- (1) Diameter 14" inches.
- (2) Total Depth 110' 6" feet.
- (3) Water Level 18' feet below top of ground.
- (4) Cased to 70' 6", Size 14".
- (5) Screen: Size 14", Length 40'.
- (6) Were any formations sealed against pollution?
_____ yes, no.

If YES depth of formation _____

Why _____

Drillers Remarks: _____

Last 2 feet almost solid gravel.

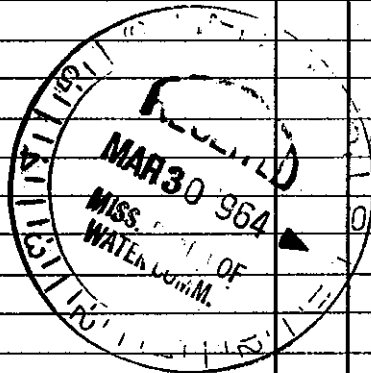

Well No. _____

(Use Back Side)

Mail this copy to Board of Water Commissioners 429 Miss. St. Jackson, Miss.