

Coahoma
H0005
4-66

MISSISSIPPI BOARD OF WATER COMMISSIONERS

WATER WELL DRILLERS LOG

4/20/66
2143

Date: April 15, 1966, Driller: Layne-Central Company County Coahoma
(Name)

(1) Owner of Land: J. H. Sherard & Son	Description & Color of Materials Sand, Clay, Red Clay, Shell, etc.	Thick- ness Feet	Depth Feet
(Name)	Clay	8	8
Sherard, Mississippi	Coarse sand	14	32
(Address)	Coarse sand, little pea		
T27	gravel	44	76
(2) Location: 1/4, 1/4, Sec. T R5W,	Gravel, coarse sand and		
0.50 miles east, of Sherard	clay at bottom	38	114
(distance) (direction) (Nearest Town)			
(3) Topography: flat			
(Hilly) (Flat) (Level)			
(4) Purpose of Well: irrigation			
(Domestic Irrigation, Municipal, Industrial, Other)			

Information upon completion of well:

(1) Diameter 16 inches.

(2) Total Depth 114 feet.

(3) Water Level 9 feet below top of ground.

(4) Cased to 56' 10", Size 16"


(5) Screen: Size 16", Length 60'

(6) Were any formations sealed against pollution?
 _____ yes, _____ no no.

If YES depth of formation _____

Why _____

Drillers Remarks: _____

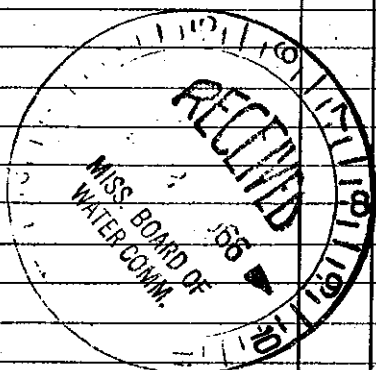

Well No.

(Use Back Side)

Mail this copy to Board of Water Commissioners 429 Miss. St. Jackson. Miss