

COAHOMA

MISSISSIPPI BOARD OF WATER COMMISSIONERS

H 11

8-24-64

WATER WELL DRILLERS LOG

Date: 8/24, 1964, Driller: Bailey Drilling Co. County: Washington (Name)

(1) Owner of Land: Bramlett  
 (Name)  
Bobo, Miss.  
 (Address)

(2) Location: 1/4, 1/4, Sec. 12 T66R5  
at Bobo  
 (distance) miles (direction) of (Nearest Town)

(3) Topography: Flat  
 (Hilly) (Flat) (Level)

(4) Purpose of Well: Domestic  
 (Domestic Irrigation  
 Municipal, Industrial, Other)

| Description & Color of Materials<br>Sand, Clay, Red Clay, Shell, etc. | Thick-<br>ness<br>Feet | Depth<br>Feet |
|---|------------------------|---------------|
| Clay  |                        | 10            |
| Sand  |                        | 85            |
| Gravel  |                        | 110           |
| Mud   |                        | 160           |
| Sand  |                        | 230           |
| Mud   |                        | 748           |
| Sand  |                        | 773           |
| Mud   |                        | 805           |
| Rock  |                        | 825           |
| Mud   |                        | 1144          |
| Sand & Mud  |                        | 1150          |
| Sand  |                        | 1236          |

Information upon completion of well:

(1) Diameter 4x3x2 1/2 inches.

(2) Total Depth 1236 feet.


(3) Water Level 1 1/2 feet below top of ground.

(4) Cased to all way Size 4x3x2 1/2

(5) Screen: Size 2 1/2; Length 30 ft

(6) Were any formations sealed against pollution?  
 yes,  no.

*Handwritten signature/initials*

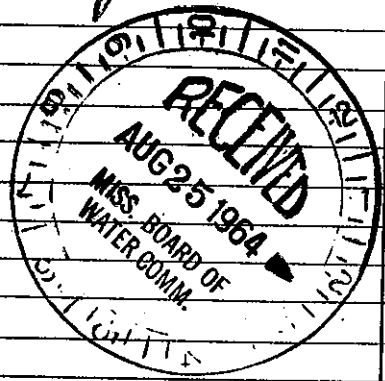

If YES depth of formation \_\_\_\_\_

Why \_\_\_\_\_

Drillers Remarks: \_\_\_\_\_

Well No.

(Use Back Side)

Mail this copy to Board of Water Commissioners 429 Miss. St. Jackson, Miss.