

COAHOMA

MISSISSIPPI BOARD OF WATER COMMISSIONERS

H 13

12-26-61


WATER WELL DRILLERS LOG

COAHOMA

Date: 12/26, 1961, Driller: Bailey Drilling Co. County: Washington

(Name)

(1) Owner of Land:	Description & Color of Materials Sand, Clay, Red Clay, Shell, etc.	Thick- ness Feet	Depth Feet
J. D. Mc Gregory (Name) Rena Lara, Miss. (Address)	Clay		16
(2) Location: 1/4, 1/4, Sec 5 8 T26R5W	Sand		70
3 miles East of Rena Lara	Gravel + Sand		135
(3) Topography: Flat	Mud		373
(4) Purpose of Well: domestic	Sand		428
(Hilly) (Flat) (Level)	Mud		490
(Domestic Irrigation Municipal, Industrial, Other)	Sand		575
Information upon completion of well:	Mud		548
(1) Diameter 4x3x2 1/2 x 2 inches.	Sand		646
(2) Total Depth 134 1/2 feet.	Mud		840
(3) Water Level at feet below top of ground.	Sand		857
(4) Cased to all way Size 4x3x2 1/2 x 2	Mud + rocks		1225
(5) Screen: Size 2", Length 20 ft.	Sand		1241
(6) Were any formations sealed against pollution?	Mud + Sand		1320
yes, <input checked="" type="checkbox"/> no.	Sand		1344
If YES depth of formation _____			
Why _____			
Drillers Remarks: _____			

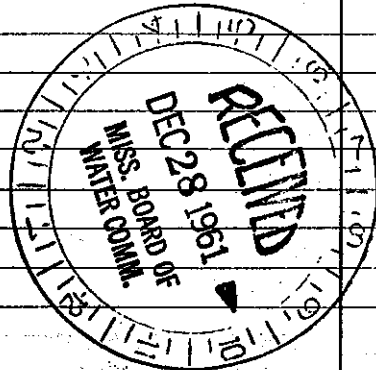

(Use Back Side)

Well No.

Mail this copy to Board of Water Commissioners 429 Miss. St. Jackson, Miss