

COAHOMA MISSISSIPPI BOARD OF WATER COMMISSIONERS

H 15

10-29-63

WATER WELL DRILLERS LOG

Date: 10/29, 1963, Driller: Galley Drilling Co County: Washington
(Name)

(1) Owner of Land: Payne Gen
(Name)
Bobo, Miss.
(Address)

(2) Location: $\frac{1}{4}$, SW, SW $\frac{1}{4}$, Sec. 12 T. 26 R. 5
at Bobo
(distance) miles (direction) of (Nearest Town)

(3) Topography: Flat
(Hilly) (Flat) (Level)

(4) Purpose of Well: Industrial
(Domestic Irrigation Municipal, Industrial, Other)

| Description & Color of Materials Sand, Clay, Red Clay, Shell, etc. | Thick- ness Feet | Depth Feet |
|---|------------------------|---------------|
| Clay | | 0 |
| Sand | | 87 |
| Gravel | | 105 |
| Mud | | 164 |
| Sand | | 452 |
| Sand + Mud | | 480 |
| Mud | | 570 |
| Rock | | 573 |
| Mud | | 800 |
| Rock + Mud | | 967 |
| Mud | | 1160 |
| Sand + Mud | | 1191 |
| Sand | | 1252 |

Information upon completion of well:

(1) Diameter 4x3x2 1/2 inches.

(2) Total Depth 1252 feet.

(3) Water Level at ground level feet below top of ground.

(4) Cased to all way Size 4x3x2 1/2


(5) Screen: Size 2 1/2, Length 30 ft

(6) Were any formations sealed against pollution?
 _____ yes, X no.

If YES depth of formation _____

Why _____

Drillers Remarks: _____

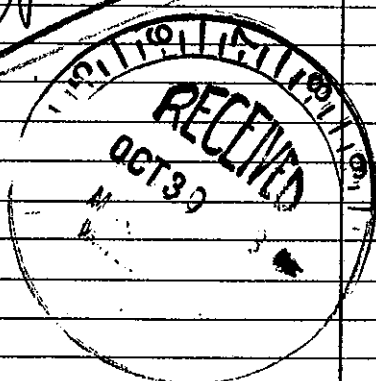

(Use Back Side)

Well No.

Mail this copy to Board of Water Commissioners 429 Miss. St. Jackson, Miss