

COAHONA MISSISSIPPI BOARD OF WATER COMMISSIONERS

H 16

7-6-64

WATER WELL DRILLERS LOG **CODED**

Date: 7-6, 1964, Driller: Joe Cantel James County Coalace
 (Name)


(1) Owner of Land: J. F. Hunter
 (Name)
Farnell Miss
 (Address)

(2) Location: 1/4, 1/4, Sec. 548 27 R. 5
1/2 miles west of Farnell
 (distance) (direction) (Nearest Town)

(3) Topography: Flat
 (Hilly) (Flat) (Level)

(4) Purpose of Well: Irrigation
 (Domestic, Irrigation, Municipal, Industrial, Other)

Description & Color of Materials Sand, Clay, Red Clay, Shell, etc.	Thick- ness Feet	Depth Feet
<u>0-21' Fine Sand</u>	<u>21</u>	<u>21</u>
<u>Coarse Sand</u>	<u>6 1/2</u>	<u>27 1/2</u>
<u>Coarse Sand and small gravel</u>	<u>78 1/2</u>	<u>105</u>

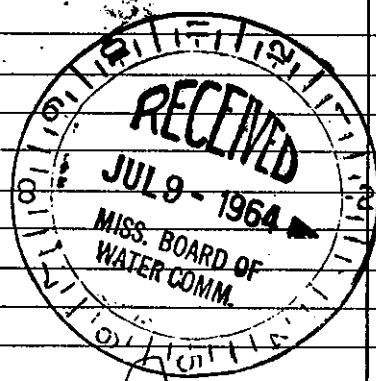

Information upon completion of well:

(1) Diameter 6 inches.

(2) Total Depth 100' feet.

(3) Water Level 14' feet below top of ground.

(4) Cased to 52, Size 6

(5) Screen: Size 6", Length 48

(6) Were any formations sealed against pollution?
 _____ yes, _____ no.

CODED

If YES depth of formation _____

Why _____

Drillers Remarks: [Signature]

Well No.

(Use Back Side)