

COAHOMA MISSISSIPPI BOARD OF WATER COMMISSIONERS

H 18
5-10-66

WATER WELL DRILLERS LOG

CODED

Date: 5-10, 1966, Driller: Tub County Farmers Assn County Coahoma
(Name)

	Description & Color of Materials Sand, Clay, Red Clay, Shell, etc.	Thick- ness Feet	Depth Feet
(1) Owner of Land: <u>T.M. Puster</u> (Name) <u>Clarkdale Miss</u> (Address)	<u>Buckshot + Clay</u>	<u>37 1/2</u>	<u>33 1/2</u>
(2) Location: <u>1/4</u> , <u>1/4</u> , Sec. <u>1 T2R5</u> <u>1</u> miles <u>NE</u> of <u>Bobo</u> (distance) (direction) (Nearest Town)	<u>Buckshot Clay Sand + Red</u>	<u>6 1/2</u>	<u>40</u>
(3) Topography: <u>Flat</u> (Hilly) (Flat) (Level)	<u>Coarse Sand + Red Rock</u> <u>with large gravel</u>	<u>7 1/4</u>	<u>114'</u>
(4) Purpose of Well: (Domestic Irrigation Municipal, Industrial, Other)	<u>Sand Rock at 114'</u> <u>Edelant formation.</u>		

Information upon completion of well:

(1) Diameter 16 inches.

(2) Total Depth 111' 10" feet.

(3) Water Level 9' feet below top of ground.

(4) Cased to 68' 10", Size 16.

(5) Screen: Size 16, Length 48'.


(6) Were any formations sealed against pollution?
_____ yes, _____ no.

If YES depth of formation _____

Why _____

Drillers Remarks: The best formation
we have found in
the area.

CODED

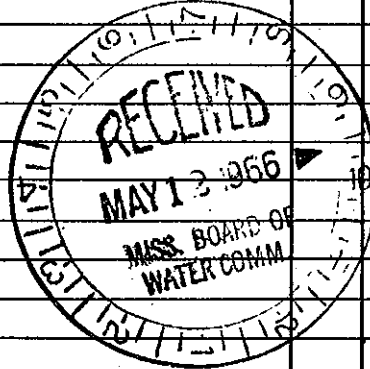

Well No.

(Use Back Side)

Mail this copy to Board of Water Commissioners 429 Miss. St. Jackson, Miss.