

H 19
9-66

WATER WELL DRILLERS LOG

CODED

Date: 9-3, 1966, Driller: Jim County Furniture County: Coahoma
(Name)

(1) Owner of Land: <u>T.M. Rusten</u> (Name)	Description & Color of Materials Sand, Clay, Red Clay, Shell, etc.	Thick- ness Feet	Depth Feet
<u>Clarksdale Miss</u> (Address)	<u>Clay & top soil</u>	<u>14</u>	<u>14</u>
(2) Location: <u>1/4, 1/4, Sec. 12 T26R 5</u>	<u>Sandy Clay</u>	<u>6 1/2</u>	<u>20 1/2</u>
<u>1/2 miles North of Bobo</u> (distance) (direction) (Nearest Town)	<u>FINE SAND</u>	<u>13</u>	<u>33 1/2</u>
(3) Topography: <u>Flat</u> (Hilly) (Flat) (Level)	<u>MED SAND</u>	<u>6 1/2</u>	<u>40</u>
(4) Purpose of Well: <u>Irrigation</u> (Domestic Irrigation Municipal, Industrial, Other)	<u>MED SAND & gravel</u>	<u>39</u>	<u>79</u>
	<u>Coarse sand</u>	<u>6 1/2</u>	<u>85 1/2</u>
	<u>Coarse sand + fine gravel</u>	<u>35</u>	<u>120 1/2</u>
	<u>ROCKS</u>		

Information upon completion of well:


- (1) Diameter 16 inches.
- (2) Total Depth 124 feet.
- (3) Water Level 23 feet below top of ground.
- (4) Cased to 70, Size 16.
- (5) Screen: Size 16, Length 48.
- (6) Were any formations sealed against pollution?
yes, no.

If YES depth of formation _____

Why _____

Drillers Remarks: _____

CODED

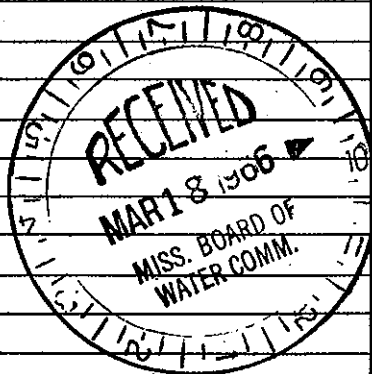

(Use Back Side)

Well No.