

COAHOMA MISSISSIPPI BOARD OF WATER COMMISSIONERS

H 22 GW 106 58

H-300

11-14-60

WATER WELL DRILLERS LOG

CODED

Date: 11/14, 1960, Driller: Fine County Farming County Cochise
(Name)


(1) Owner of Land:	Description & Color of Materials Sand, Clay, Red Clay, Shell, etc.	Thick- ness Feet	Depth Feet
(Name) <u>Robom Braultt</u>			
(Address) <u>Bobo Miss</u>	<u>clay</u>	<u>35</u>	<u>35</u>
(2) Location: <u>1/4</u> , <u>26W</u> , <u>23R S</u> , Sec. <u>11</u>	<u>Fine Sand</u>	<u>8</u>	<u>43</u>
(distance) <u>1/4</u> miles <u>west</u> , of <u>Bobo</u>	<u>Clay & Sand</u>	<u>15</u>	<u>58</u>
(direction) (Nearest Town)	<u>Coarse Sand & P. Sand</u>	<u>43</u>	<u>101</u>
(3) Topography: <u>Level</u>			
(4) Purpose of Well: <u>irrigation</u>			

Information upon completion of well:

- (1) Diameter 16 inches.
- (2) Total Depth 101 feet.
- (3) Water Level 25 feet below top of ground.
- (4) Cased to 60, Size 16
- (5) Screen: Size 12, Length 41
- (6) Were any formations sealed against pollution?
 yes, no.

CODED

If YES depth of formation _____
 Why _____
 Drillers Remarks: _____

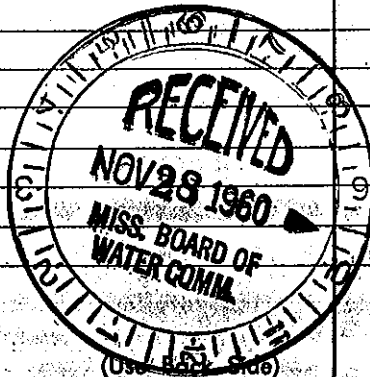

Well No. _____

Mail this copy to Board of Water Commissioners 429 Miss. St. Jackson, Miss.